
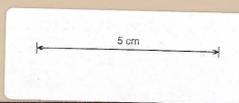


17-300 E

18-500 N

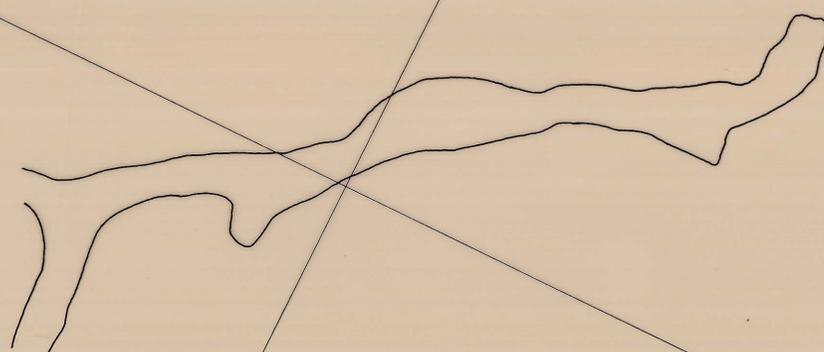

DATE	MANAGER	SURVEYOR	RENISON LIMITED SURVEY.		DRAWING No.
31-12-78	<i>[Signature]</i>	<i>[Signature]</i>	DRAWN <i>F.M.H.</i>	DATE <i>12-3-79</i> SCALE <i>1:500</i>	<i>116:001</i>
			2000 SOUTH STEBBINS		<i>79154</i>
			LEVEL: SILL (2011)		

0376_490