
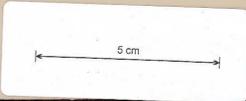


18-750 N.

17-150 E.

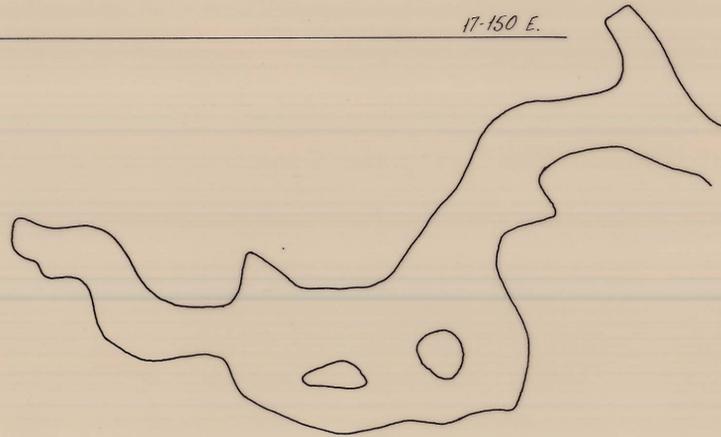

DATE	MANAGER	SURVEYOR	RENISON LIMITED SURVEY.		DRAWING No.
3-12-78	<i>[Signature]</i>	<i>[Signature]</i>	DRAWN <i>F.M.H.</i>	DATE 9-3-78	SCALE 1:500
			1900 NORTH STEBBINS		73:001
			Nth. LEVEL: 1920. Sth. LEVEL: 1941.		78169

0376_493