



16-800E

19-200N

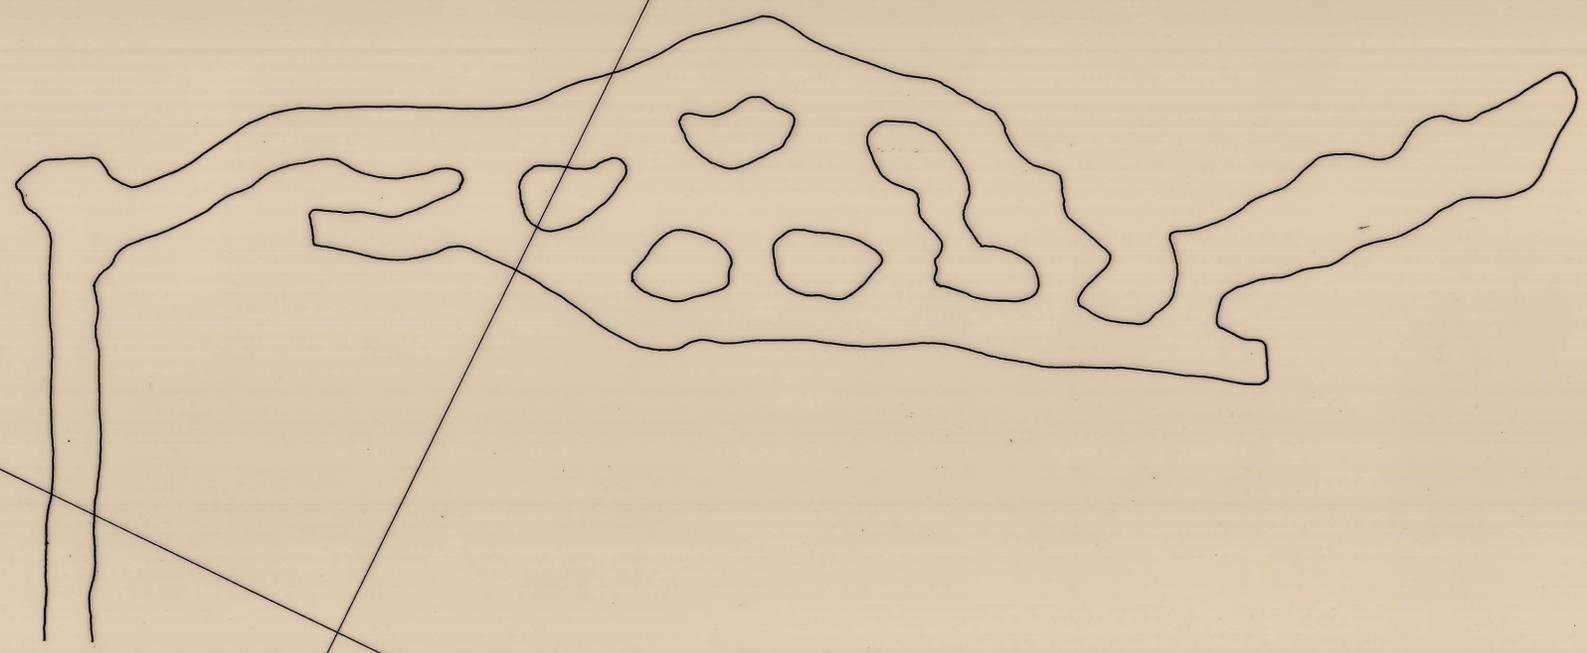

0376\_498

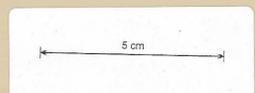

DATE	MANAGER	SURVEYOR	RENISON LIMITED SURVEY.			DRAWING No.
31-12-80	<i>John Hylle</i>	<i>W. Taylor</i>	DRAWN R.N.D.	DATE 1-1-81	SCALE 1:500.	110-001
			2025 MURCHISON STOPE			
			LEVEL: 2036			

81381

0376-498