
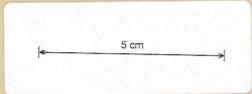


16-800E

18-200N

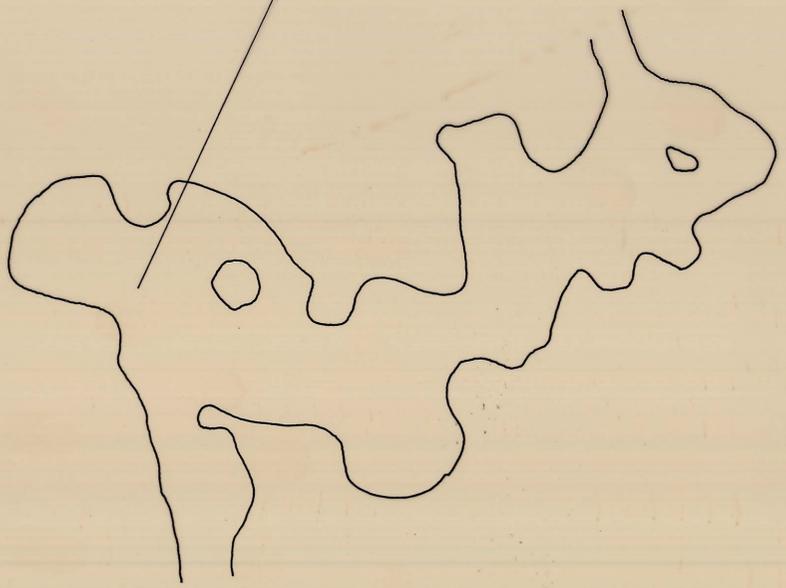

DATE	MANAGER	SURVEYOR	RENISON LIMITED SURVEY.		DRAWING No.
31-12-88	<i>[Signature]</i>	<i>[Signature]</i>	DRAWN R.N.D	DATE 1-1-89	SCALE 1:500
			2075 MURCHISON STOPE		68-014
			LEVEL: 2105		

81350

0376_499