
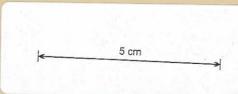


16-800 N

16-900 E

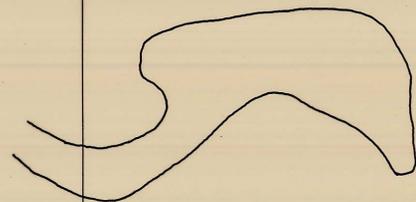

| DATE | MANAGER | SURVEYOR | RENISON LIMITED SURVEY. | | | DRAWING No. |
|----------|--------------------|--------------------|--|-------------|--------------|-------------|
| 31-12-80 | <i>[Signature]</i> | <i>[Signature]</i> | DRAWN R.N.D. | DATE 1-1-80 | SCALE 1/500. | 27:079 |
| | | | 2040 NTH STEBBINS STOPE LEVEL: 2150.0 | | | |

81379

0376_500