
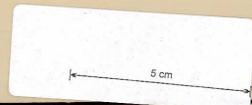


16-700E

19-000N

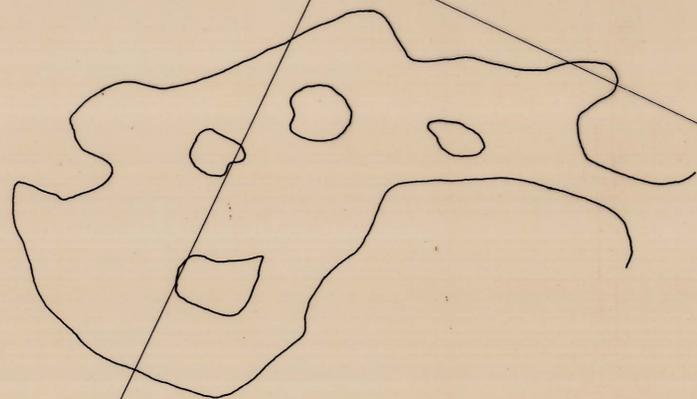

DATE	MANAGER	SURVEYOR	RENISON LIMITED SURVEY.		DRAWING No.
31-12-77	<i>[Signature]</i>	<i>[Signature]</i>	DRAWN. F.M.H.	DATE. 15-3-78	SCALE 1:500
			2125 DREADNOUGHT STOPE.		17:001
			LEVEL: 2175.		78163

0376_516