
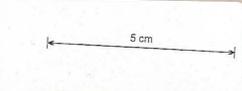
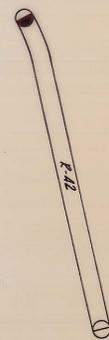


16.800 E.

19.300 N.

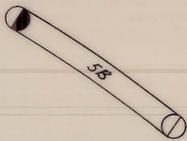

DATE	MANAGER	SURVEYOR	RENISON LIMITED SURVEY.		DRAWING No.
31/12/78	<i>[Signature]</i>	<i>[Signature]</i>	DRAWN F.M.H.	DATE 9-3-79	SCALE 1:500
			2080 NORTH BASSETT RISES		114:001
					79153

0376_523