
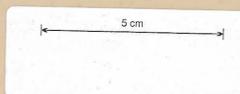


17-200E

18-500N

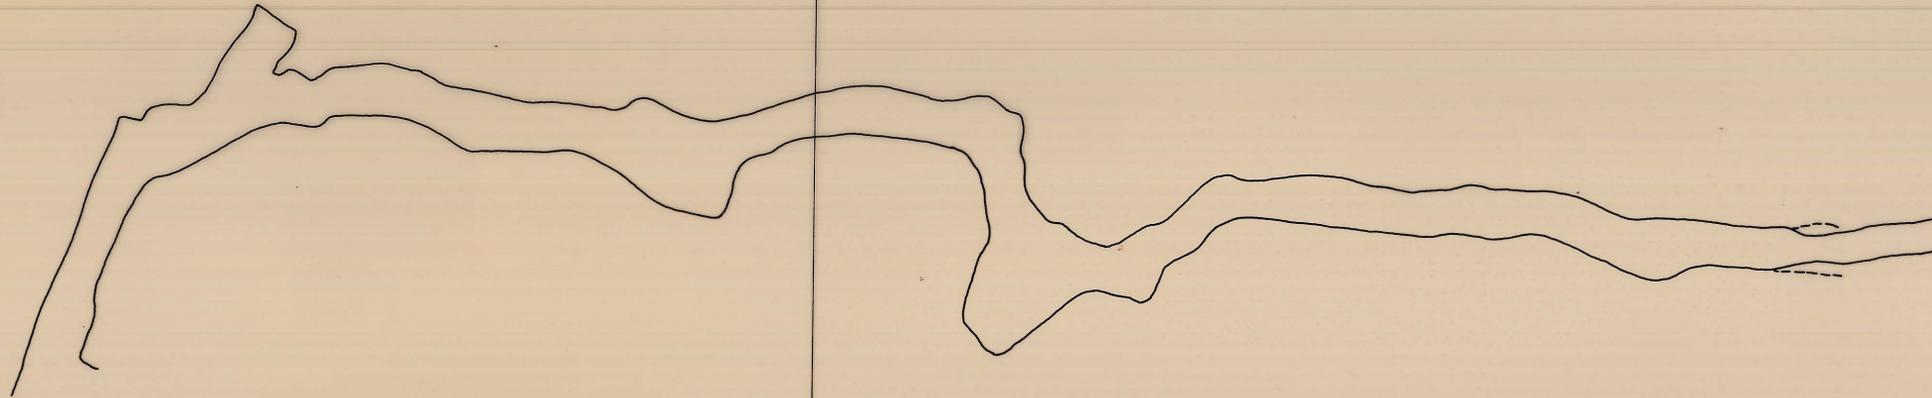

DATE	MANAGER	SURVEYOR	RENISON LIMITED SURVEY		DRAWING No
31-12-80	<i>[Signature]</i>	<i>[Signature]</i>	DRAWN RND	DATE 1-1-81	SCALE 1:500
			2035 HOWARD STOPE		128:001
			LEVEL: 2044.0 SILL.		

81389

0376_529