
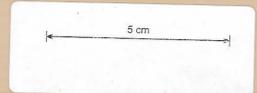


16-800 E

19-200 N

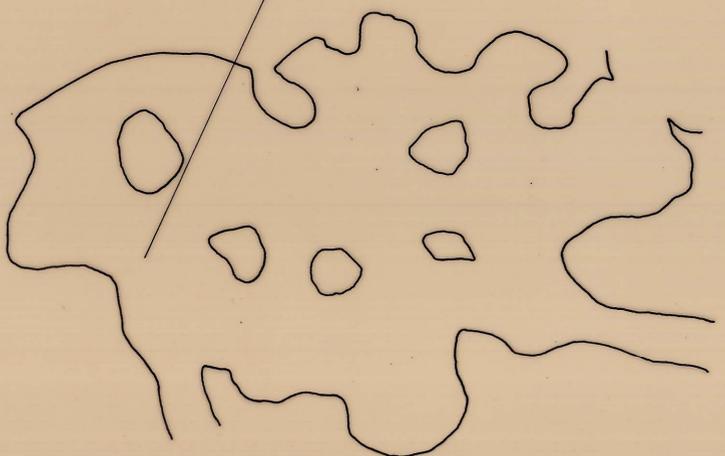

DATE	MANAGER	SURVEYOR	RENISON LIMITED SURVEY			DRAWING No.
31-12-79	<i>[Signature]</i>	<i>[Signature]</i>	DRAWN F.M.H.	DATE 28-2-80	SCALE 1:500	68:014
			2075 MURCHISON STOPE LEVEL: 2102			

80050

0376\_532