


19-000 N

16-900 E

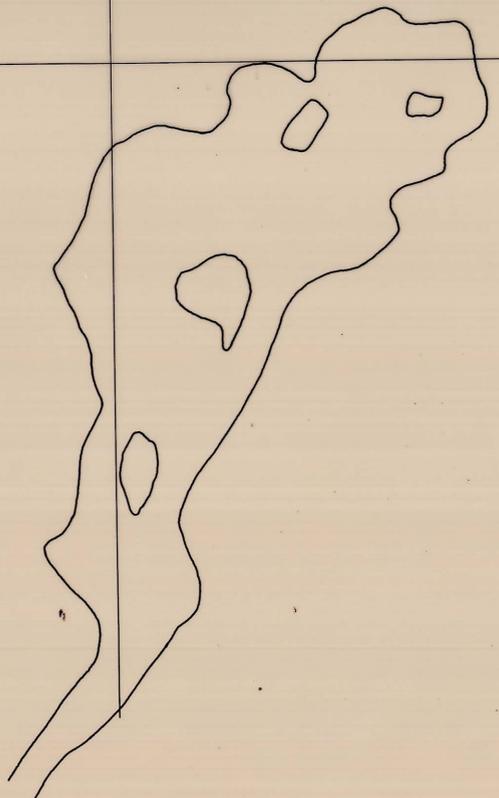

5 cm

DATE	MANAGER	SURVEYOR	RENISON LIMITED SURVEY.		DRAWING No.
31-12-79	<i>[Signature]</i>	<i>[Signature]</i>	DRAWN F.M.H.	DATE 27-2-80 SCALE 1:500	17:001
			2070 DREADNOUGHT STOPE LEVEL: 2100		

80047

0376_535