


MICROFILMED

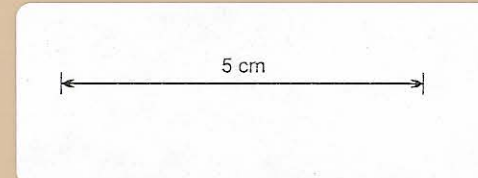

DATE	MANAGER	SURVEYOR	RENISON LIMITED SURVEY			DRAWING N ^o
31-12-72	<i>W. Horton</i>	<i>W. A. P.</i>				22:079
			DRAWN : P.W.K.	DATE : 26-2-73	SCALE : 1:500	
			UPPER NORTH STEBBINS STOPE LEVEL : 2110.00			