


MICROFILMED

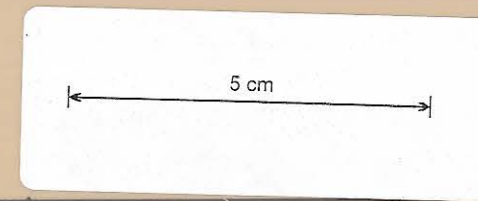

DATE	MANAGER	SURVEYOR	RENISON LIMITED SURVEY			DRAWING NO
31-12-72	<i>McIntosh</i>	<i>W. J. King</i>	DRAWN: P.W.K.	DATE: 26-2-73	SCALE: 1:500	22:079
			UPPER NORTH STEBBINS STOPE LEVEL: 2100.00			

75021