




16,900.5.

18,900.1

MICROFILMED

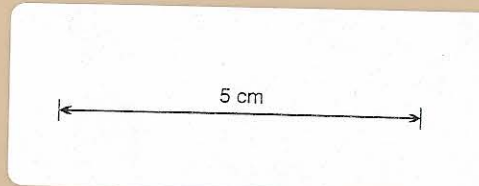

DATE	MANAGER	SURVEYOR	RENISON LIMITED SURVEY			DRAWING N°
3/12/72	<i>P.W.K.</i>	<i>[Signature]</i>				22:079
			DRAWN: P.W.K.	DATE: 26.2.73	SCALE: 1:500	
			UPPER NORTH STEBBINS STOPE			
			LEVEL: 2080.00			

73019

0376_546