



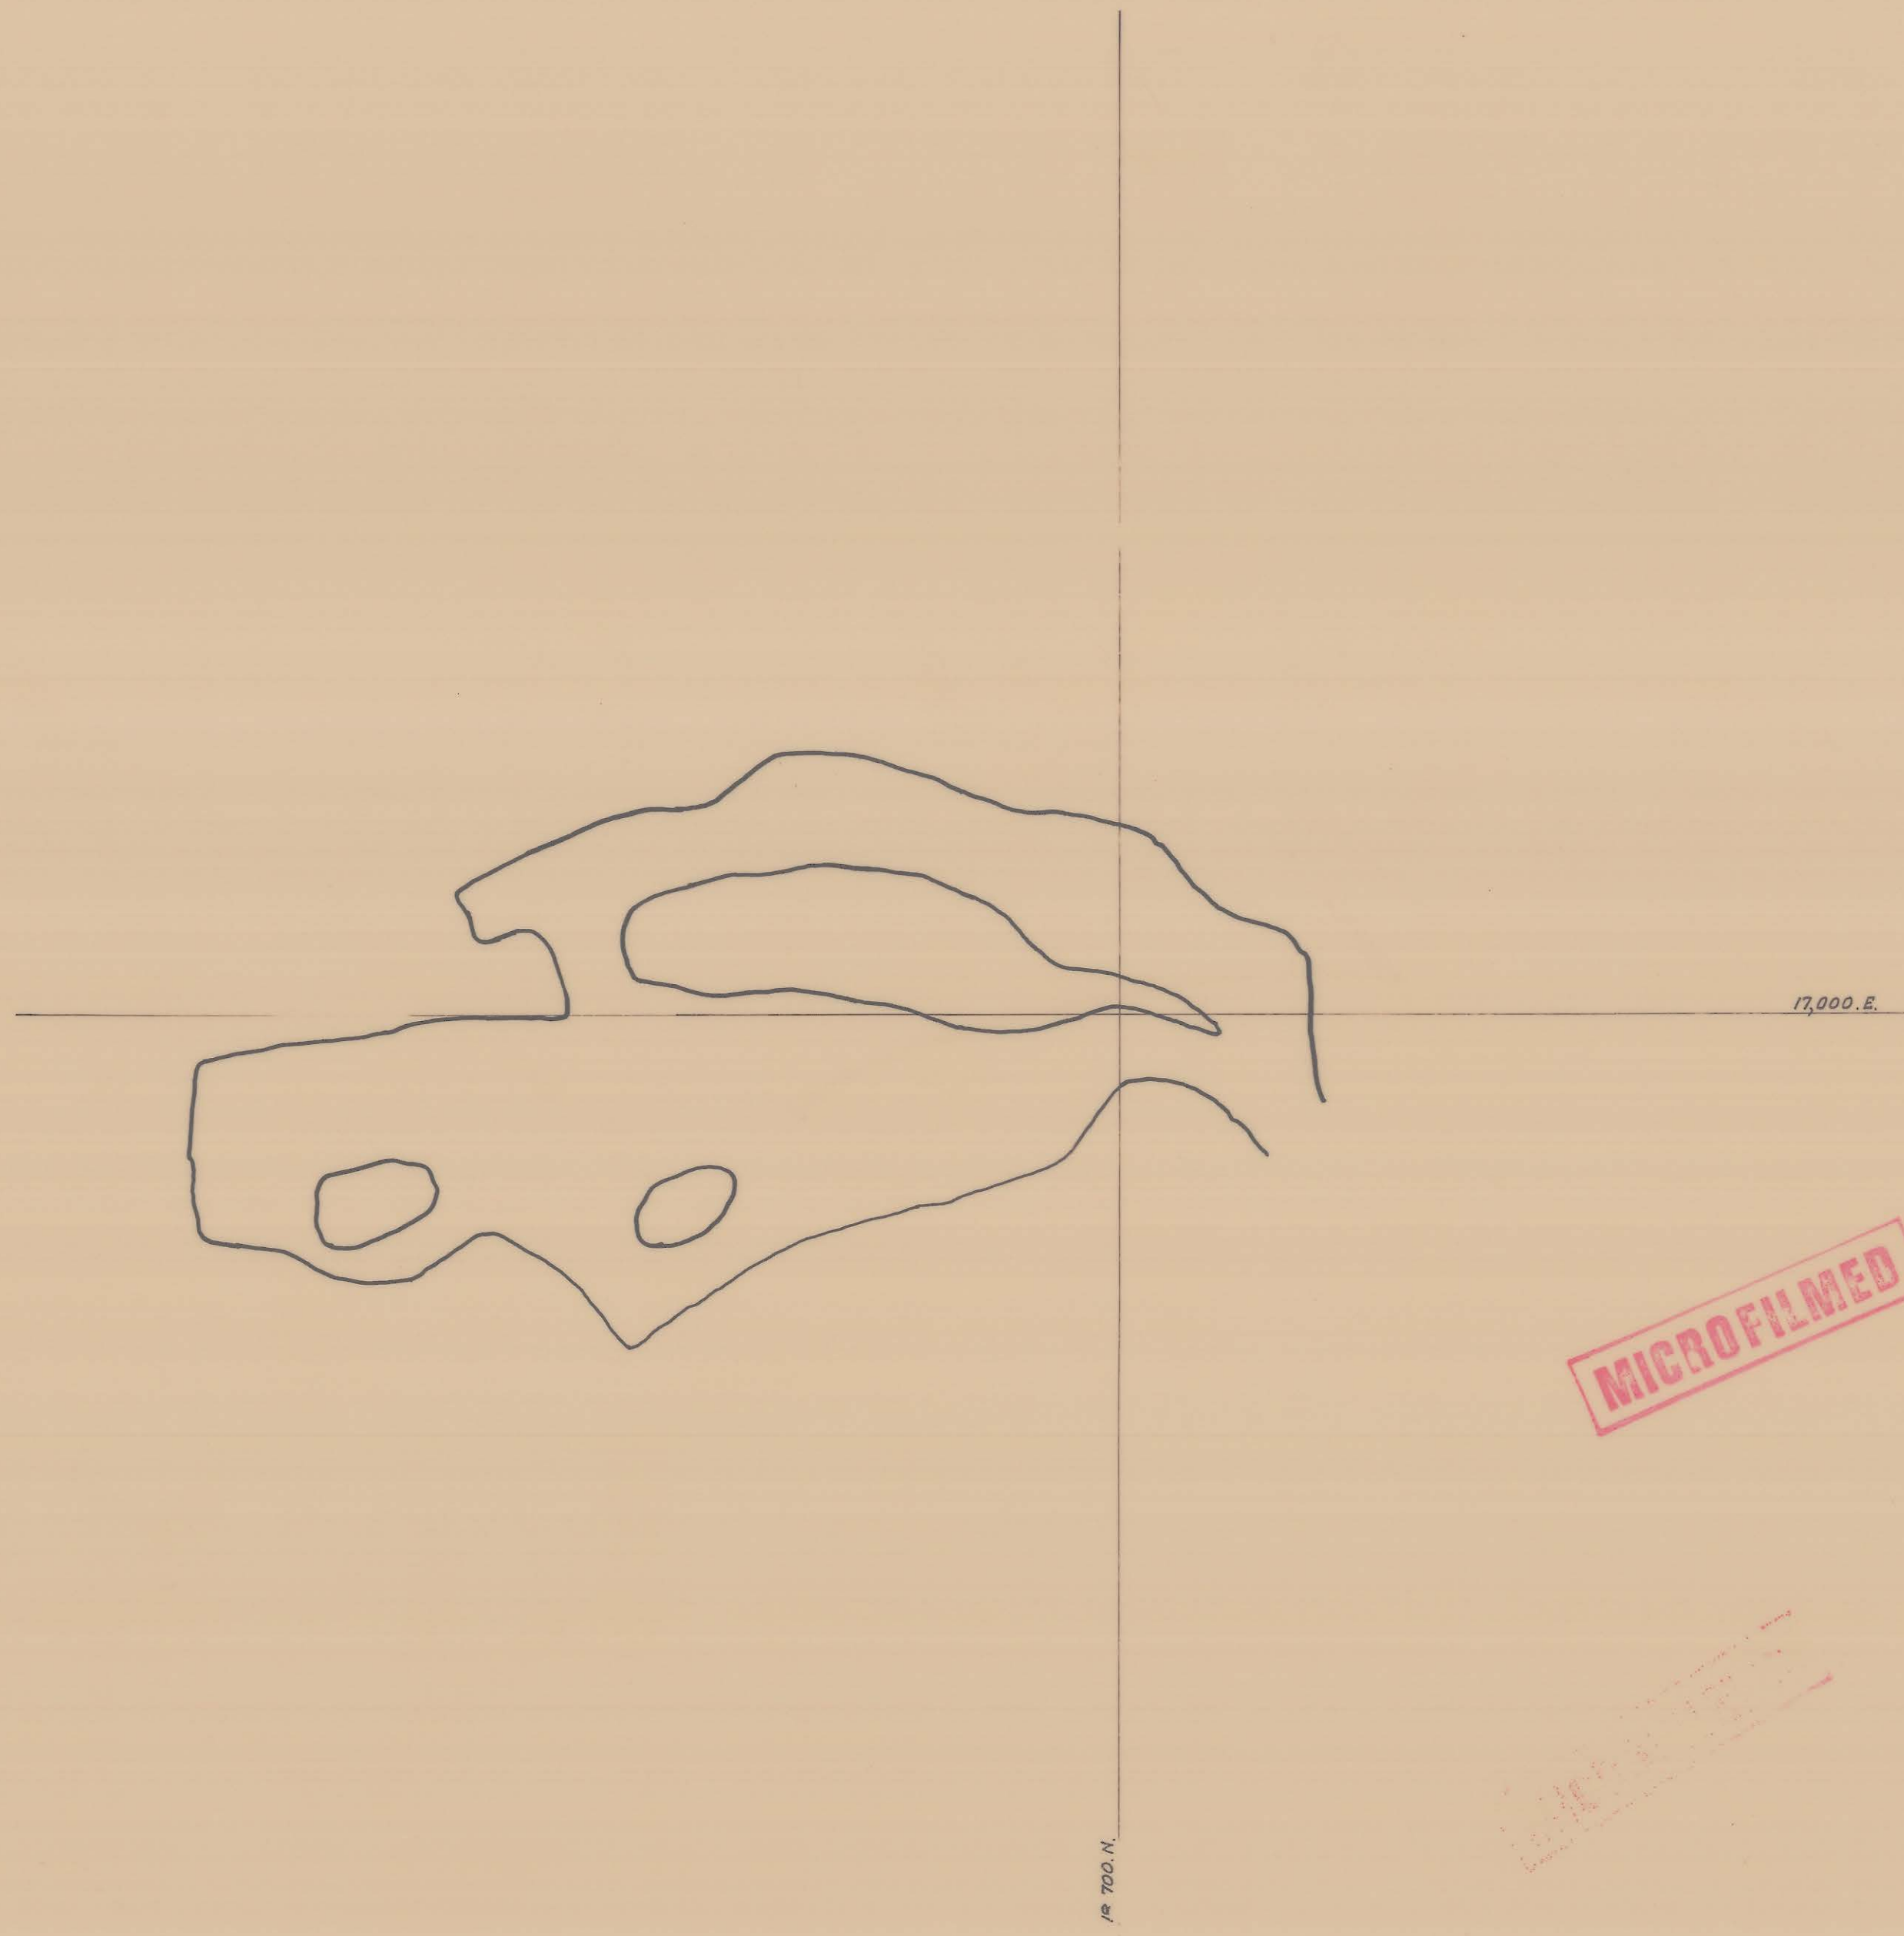

MICROFILMED

ENCLOSURE

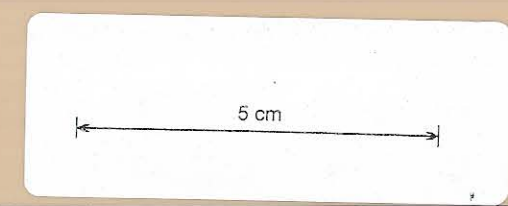

DATE	MANAGER	SURVEYOR	RENISON LIMITED SURVEY			DRAWING N°
3-12-72	<i>[Signature]</i>	<i>[Signature]</i>	DRAWN: P.W.K.	DATE: 23-2-73	SCALE: 1:500	22:079
			UPPER NORTH STEBBINS STOPE			
			LEVEL: 2070.00			

75918

0376_547