


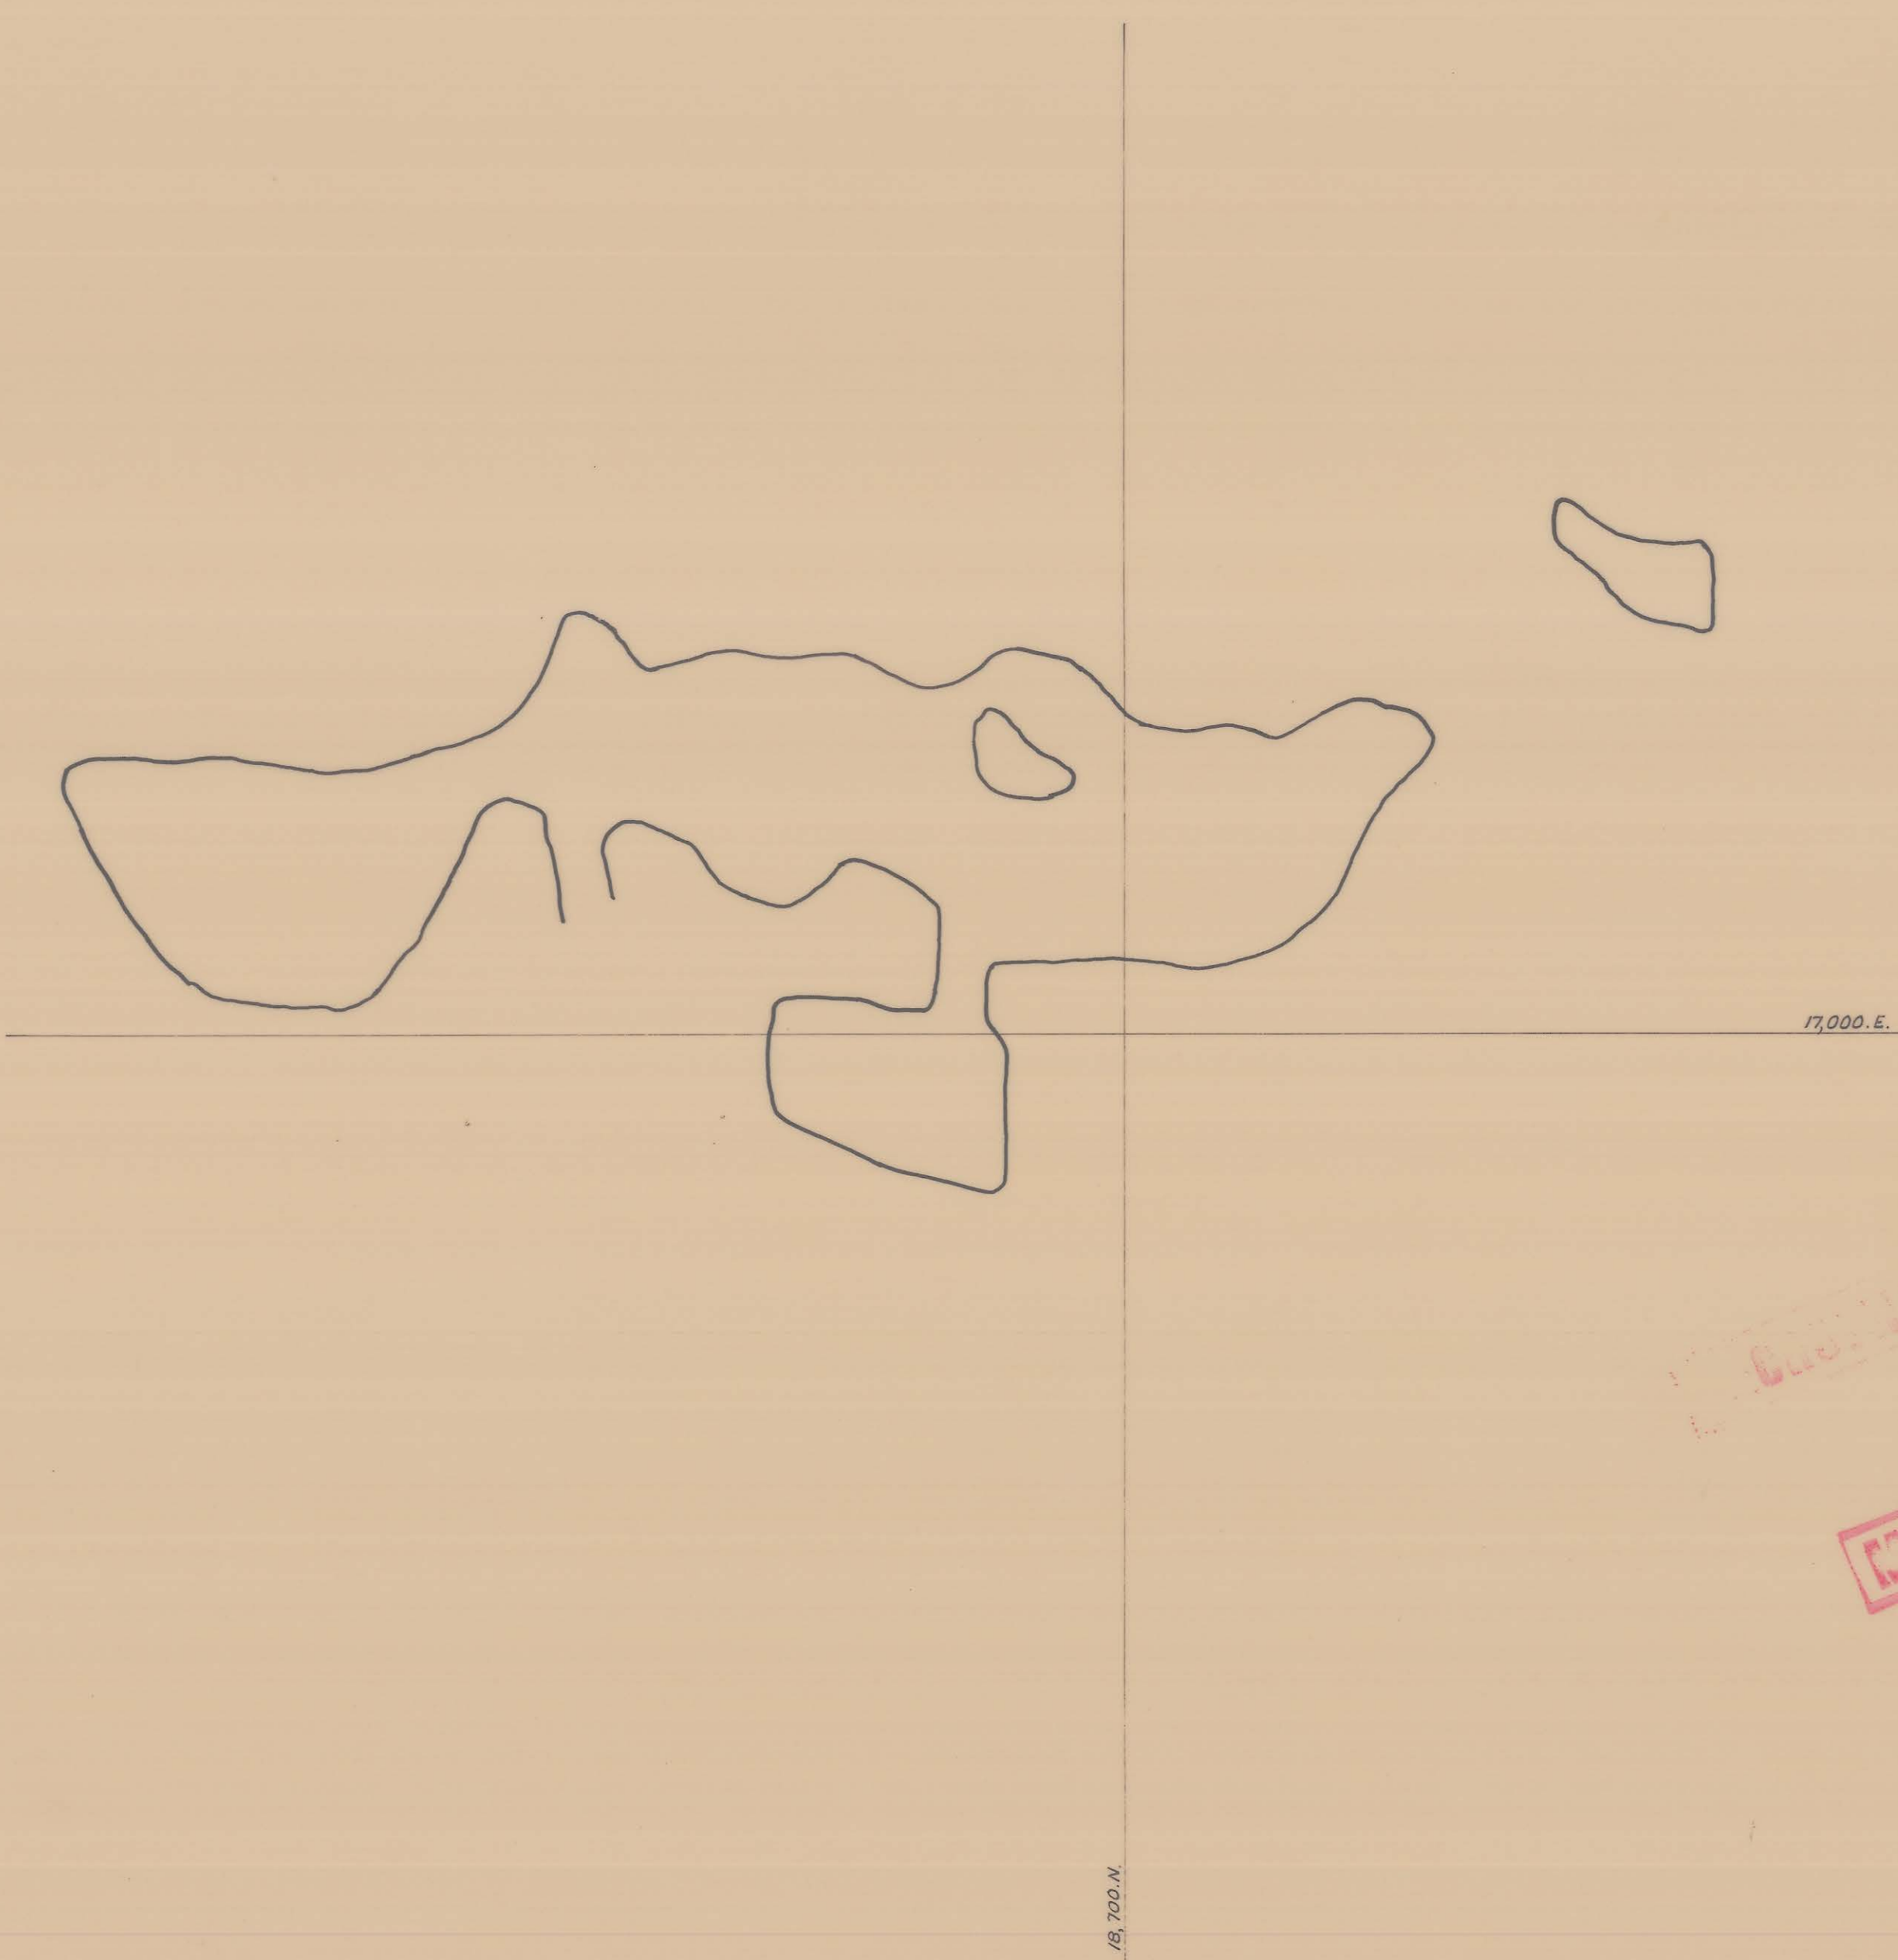

ENCLOSURE
MICROFILMED

5 cm

DATE	MANAGER	SURVEYOR	RENISON LIMITED SURVEY			DRAWING NO.
31-12-72	<i>W. H. H. H.</i>	<i>W. H. H. H.</i>	DRAWN: P.W.K. DATE: 23-2-73 SCALE: 1:500			22:079
			UPPER NORTH STEBBINS STOPE			
			LEVEL: 2060.00			

73017

0376_548