


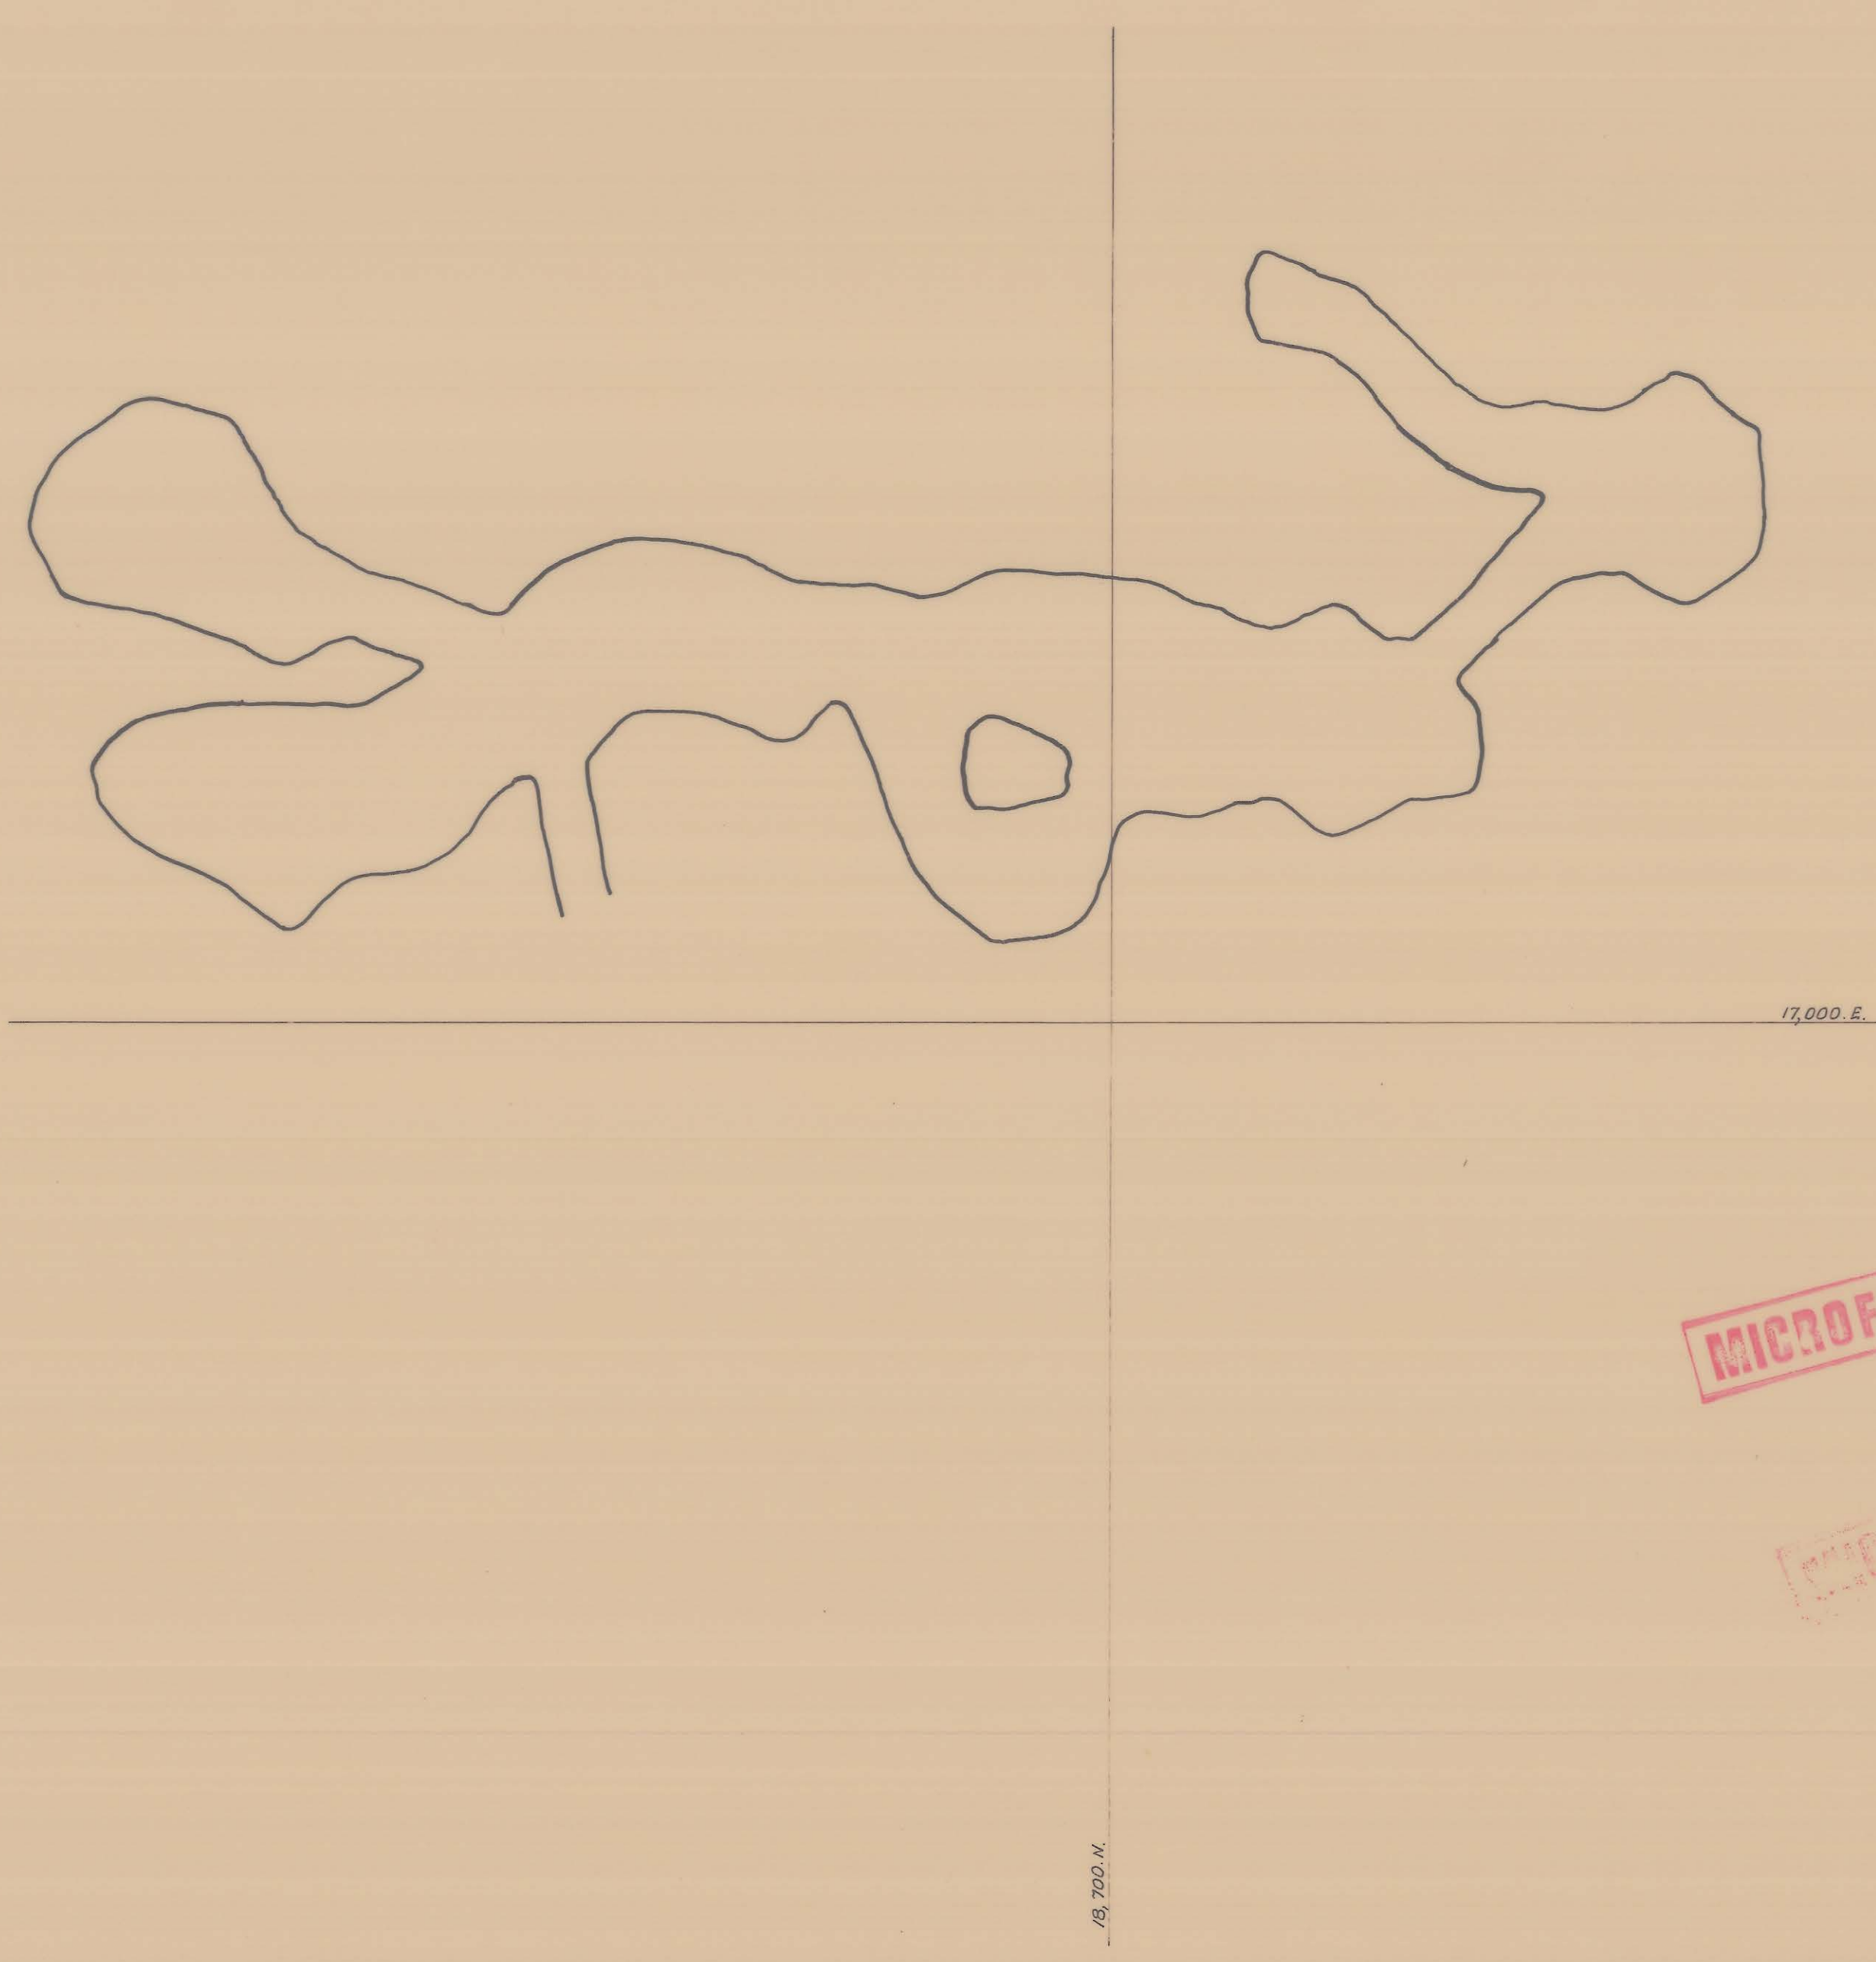

MICROFILMED

MICROFILMED

5 cm

DATE	MANAGER	SURVEYOR	RENISON LIMITED SURVEY			DRAWING N°
3/12/72	<i>[Signature]</i>	<i>[Signature]</i>	DRAWN : P.W.K. DATE : 23-2-77 SCALE : 1:500			22:079
			UPPER NORTH STEBBINS STOPE			
			LEVEL : 2050.00			

73016

0376_549