




MICROFILMED

MICROFILMED

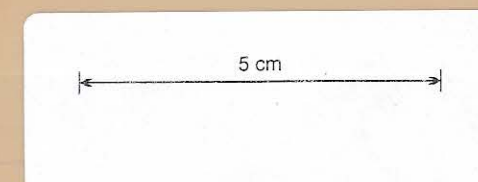

DATE	MANAGER	SURVEYOR	RENISON LIMITED SURVEY		DRAWING N°
31-12-72	<i>McIntosh</i>	<i>W. J. J.</i>	DRAWN: P.W.K.	DATE: 7-3-73	SCALE: 1:500
			LOWER NORTH STEBBINS STOPE LEVEL 1990		22:079

75012

0376_553