


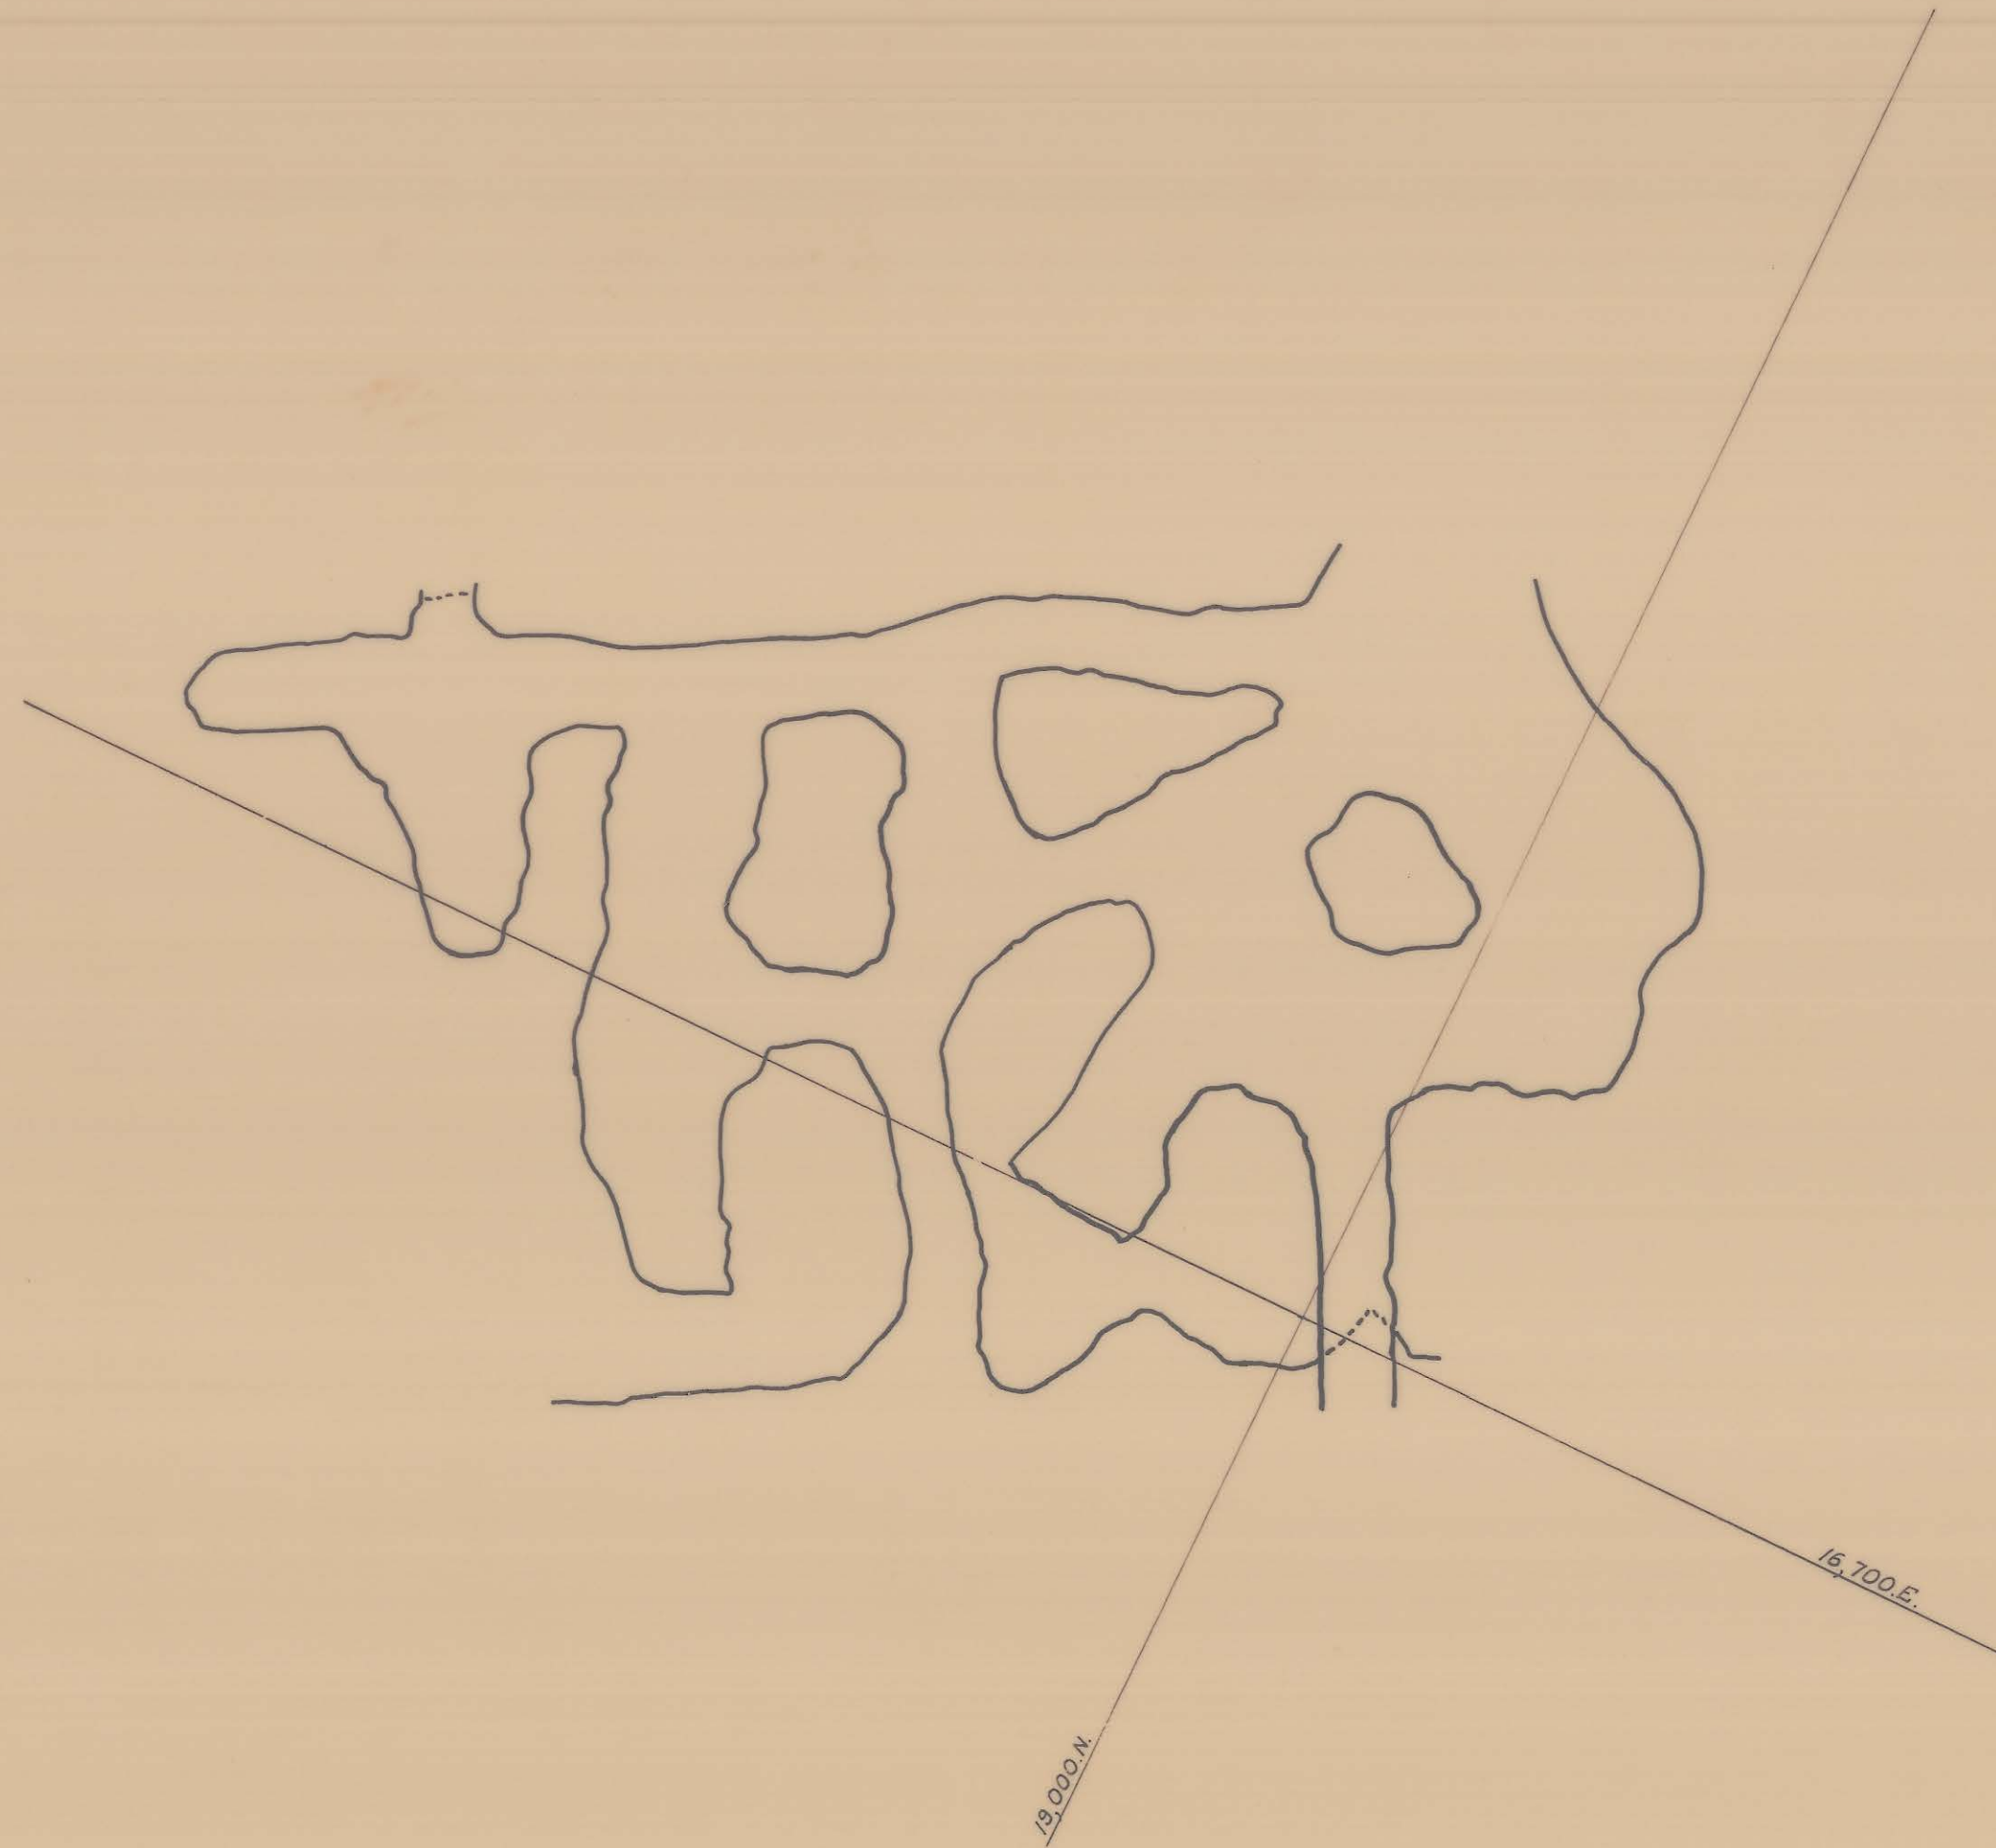

MICROFILMED

5 cm

DATE	MANAGER	SURVEYOR	RENISON LIMITED SURVEY			DRAWING N°
3/12/72	<i>Michael</i>	<i>MS</i>				17:001
			DRAWN : P.W.K.	DATE : 23.2.73	SCALE : 1 : 500	
			UPPER DREADNOUGHT STOPE			
			LEVEL : 2142.00			

73009