


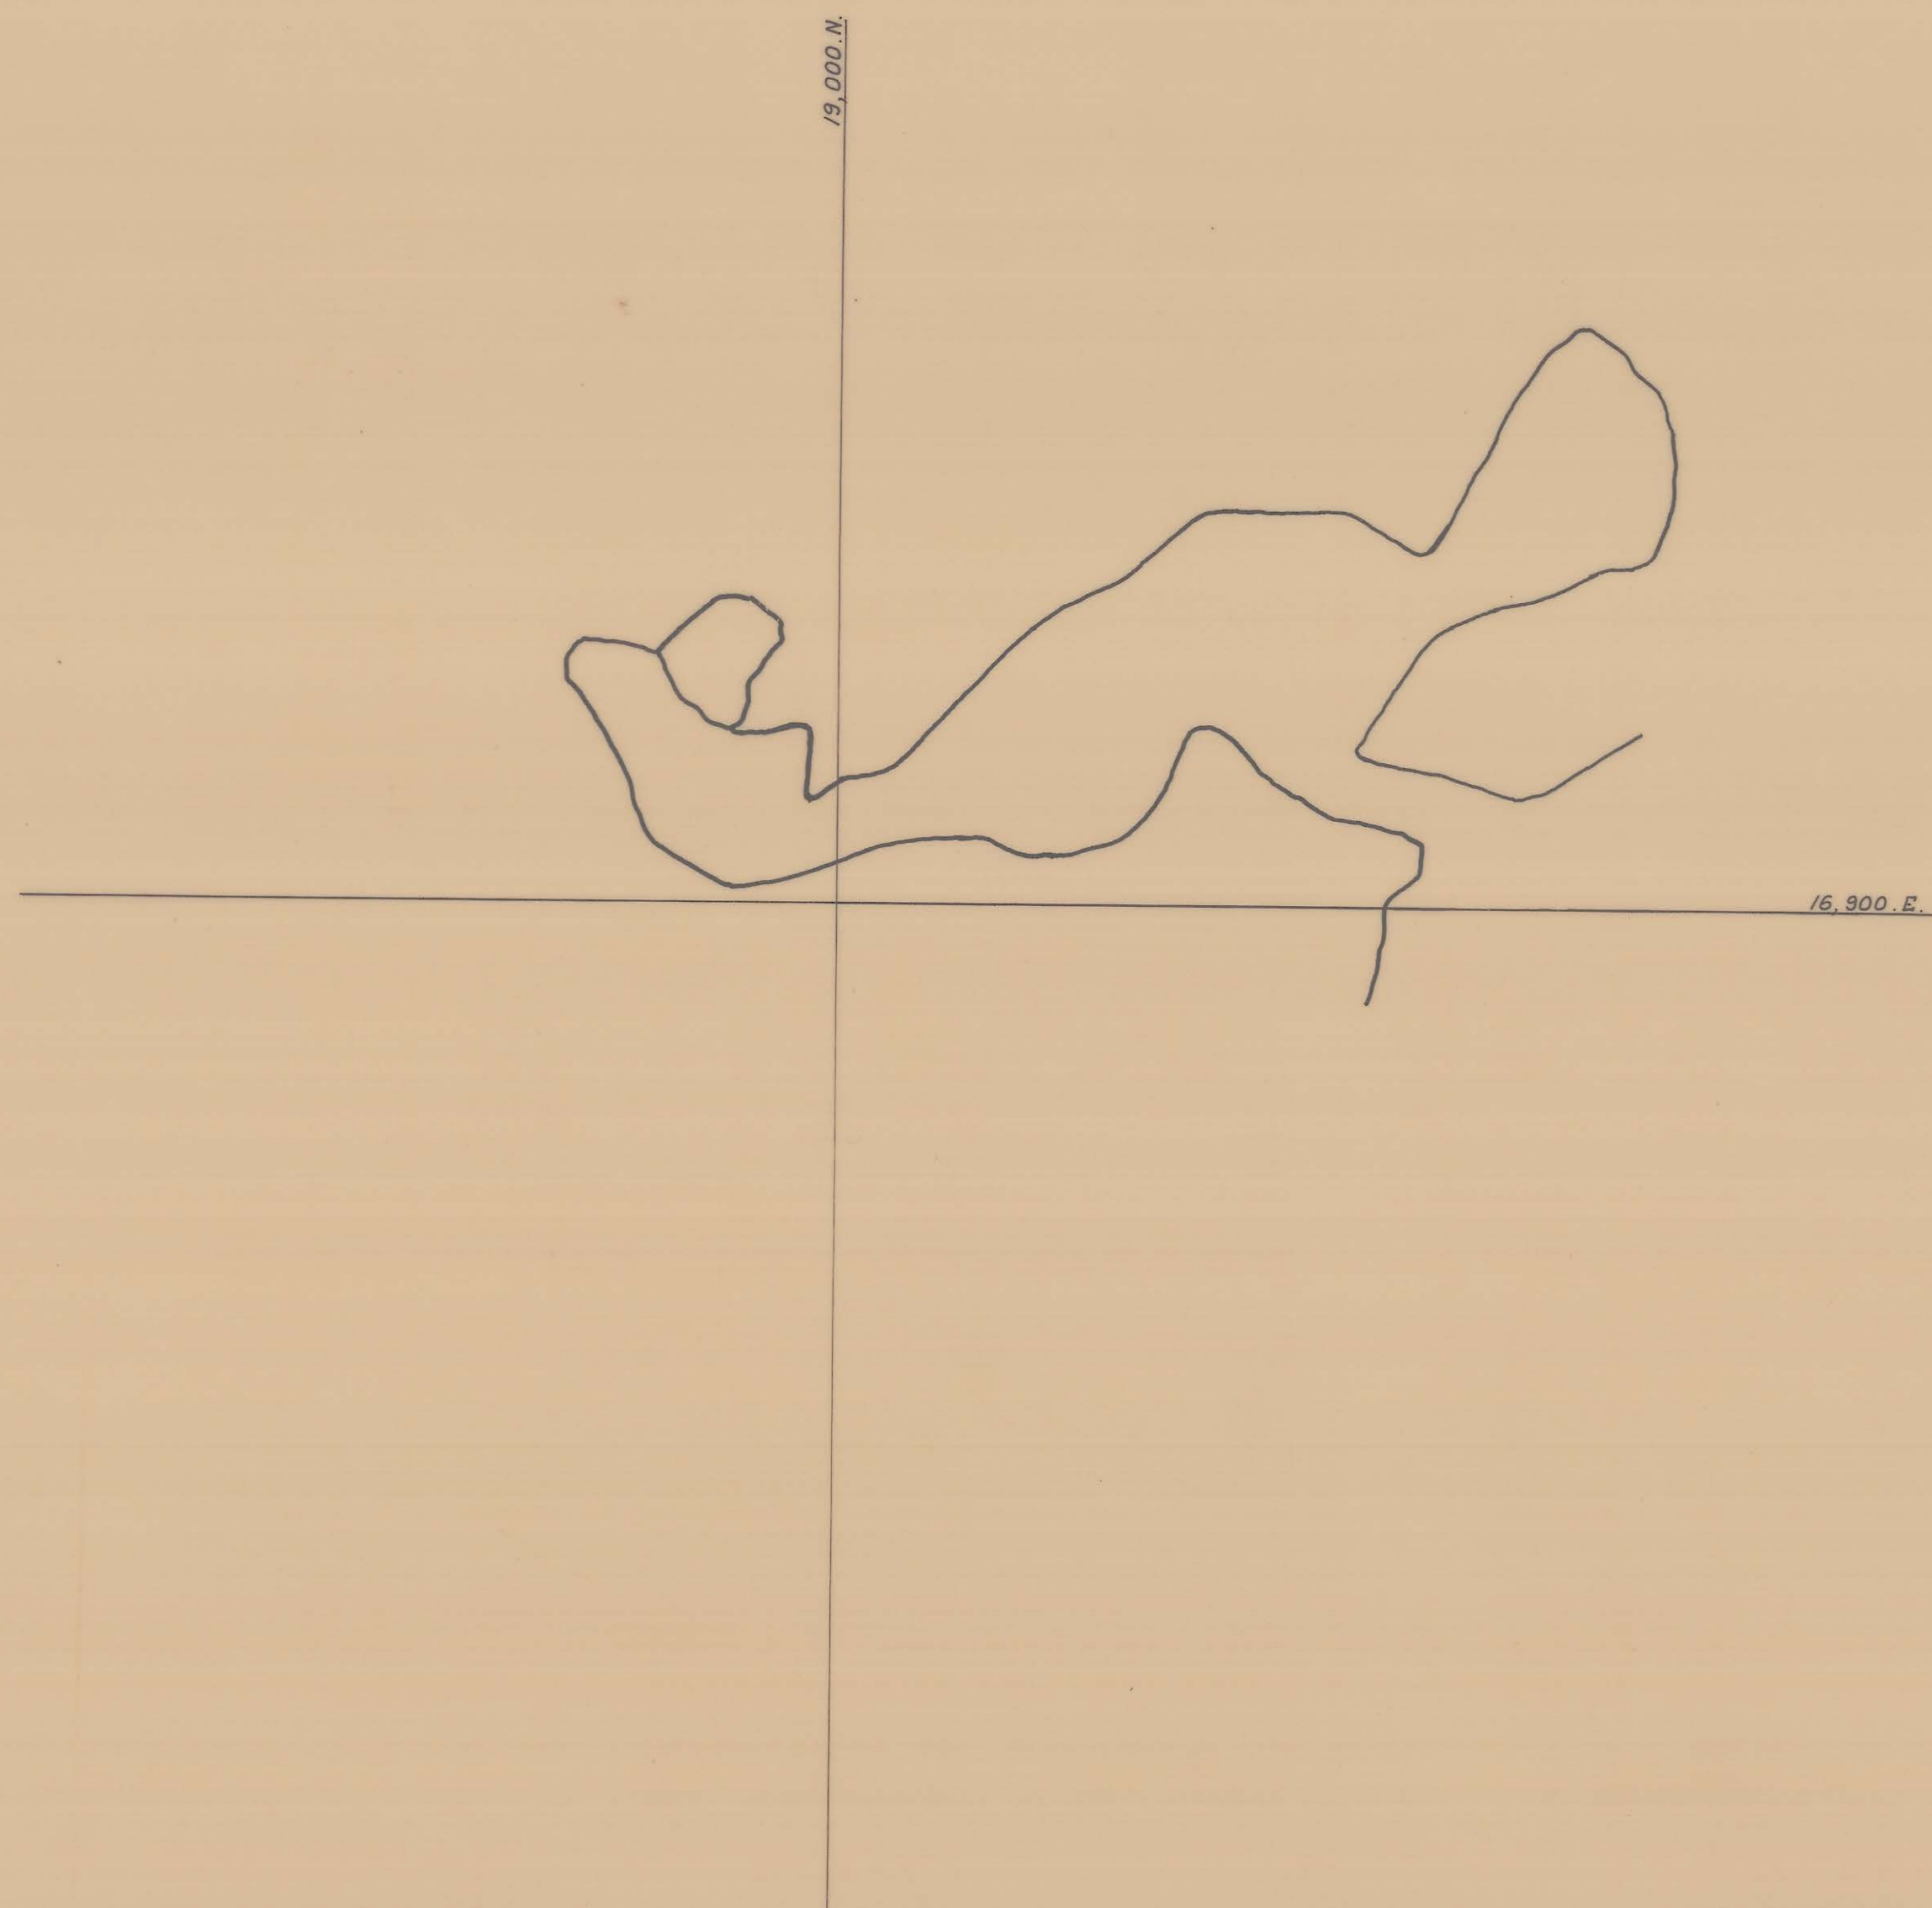

ENCROFILMED
ENCROFILMED

5 cm

DATE	MANAGER	SURVEYOR	RENISON LIMITED SURVEY			DRAWING NO
24.2.72	M. Challen	W. May	DRAWN: P.W.K. DATE: 22.3.73 SCALE: 1:500			17:001
			LOWER DREADNOUGHT STOPE LEVEL 2080			