


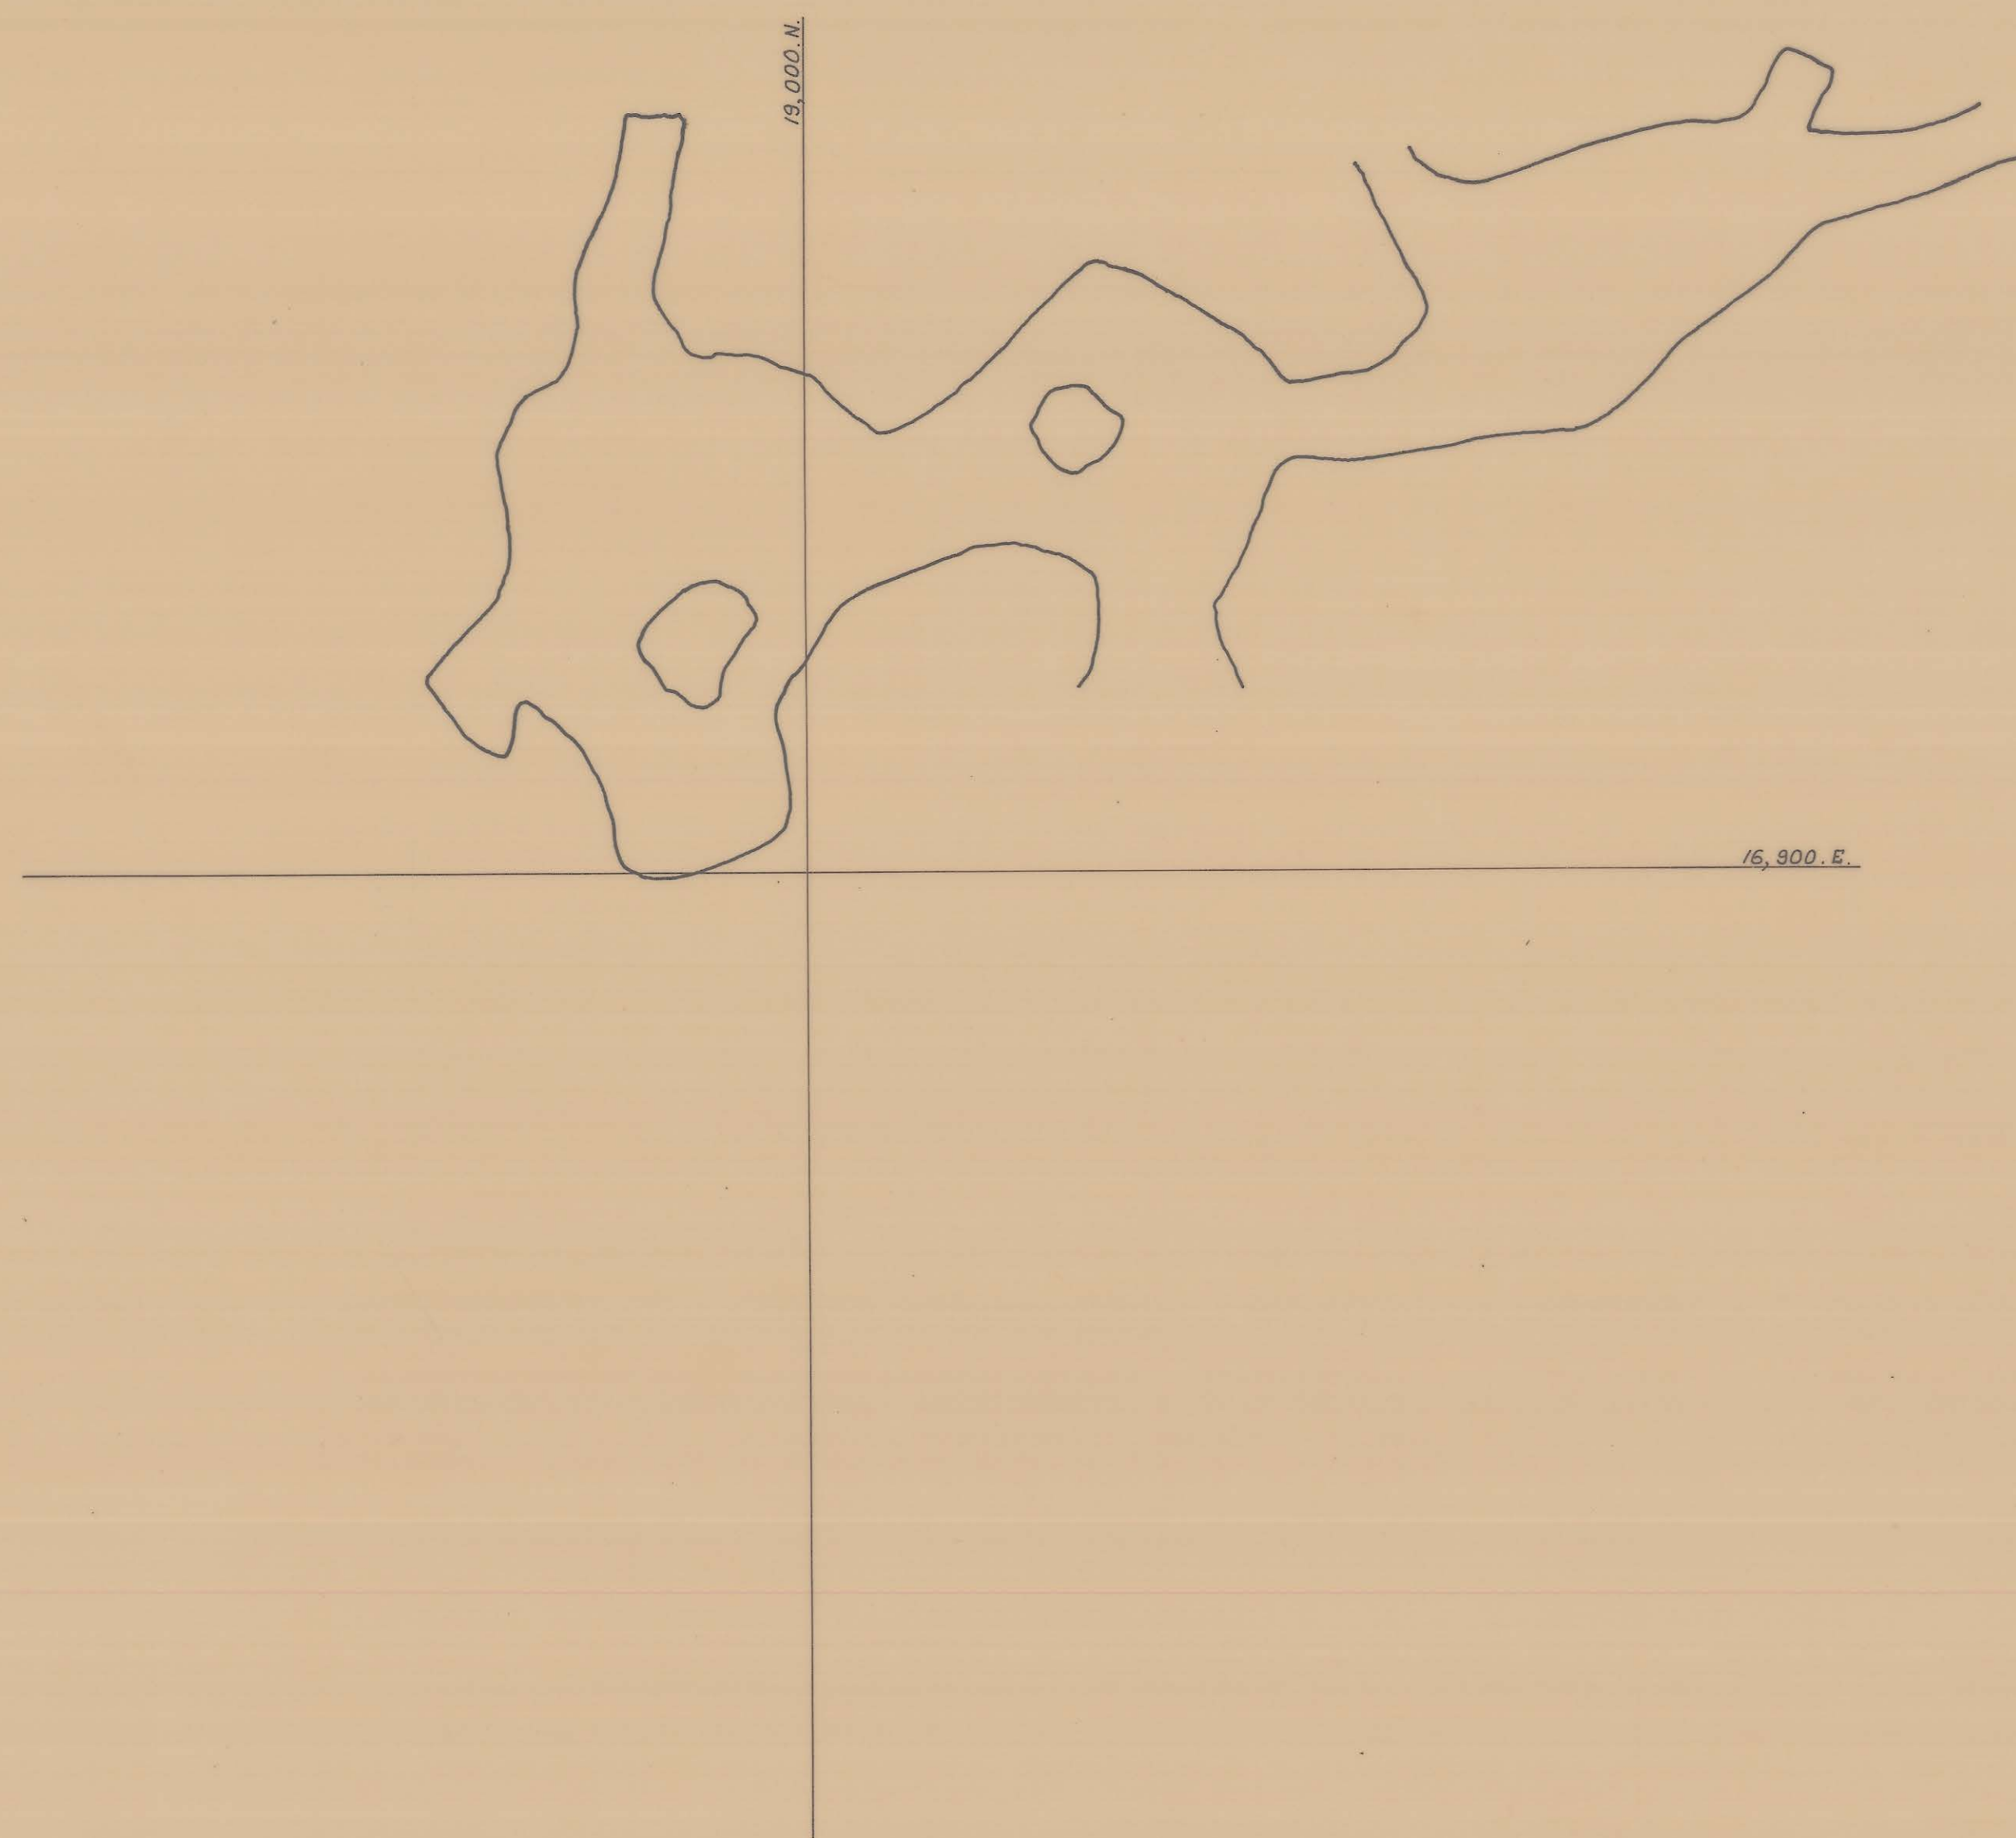

ENCLOSURE

5 cm

DATE	MANAGER	SURVEYOR	RENISON LIMITED SURVEY			DRAWING N°
9/12-72	<i>[Signature]</i>	<i>[Signature]</i>				17:001
			DRAWN: P.W.K. DATE: 22-3-73 SCALE: 1:500			
			LOWER DREADNOUGHT STOPE			
			LEVEL 2070			