


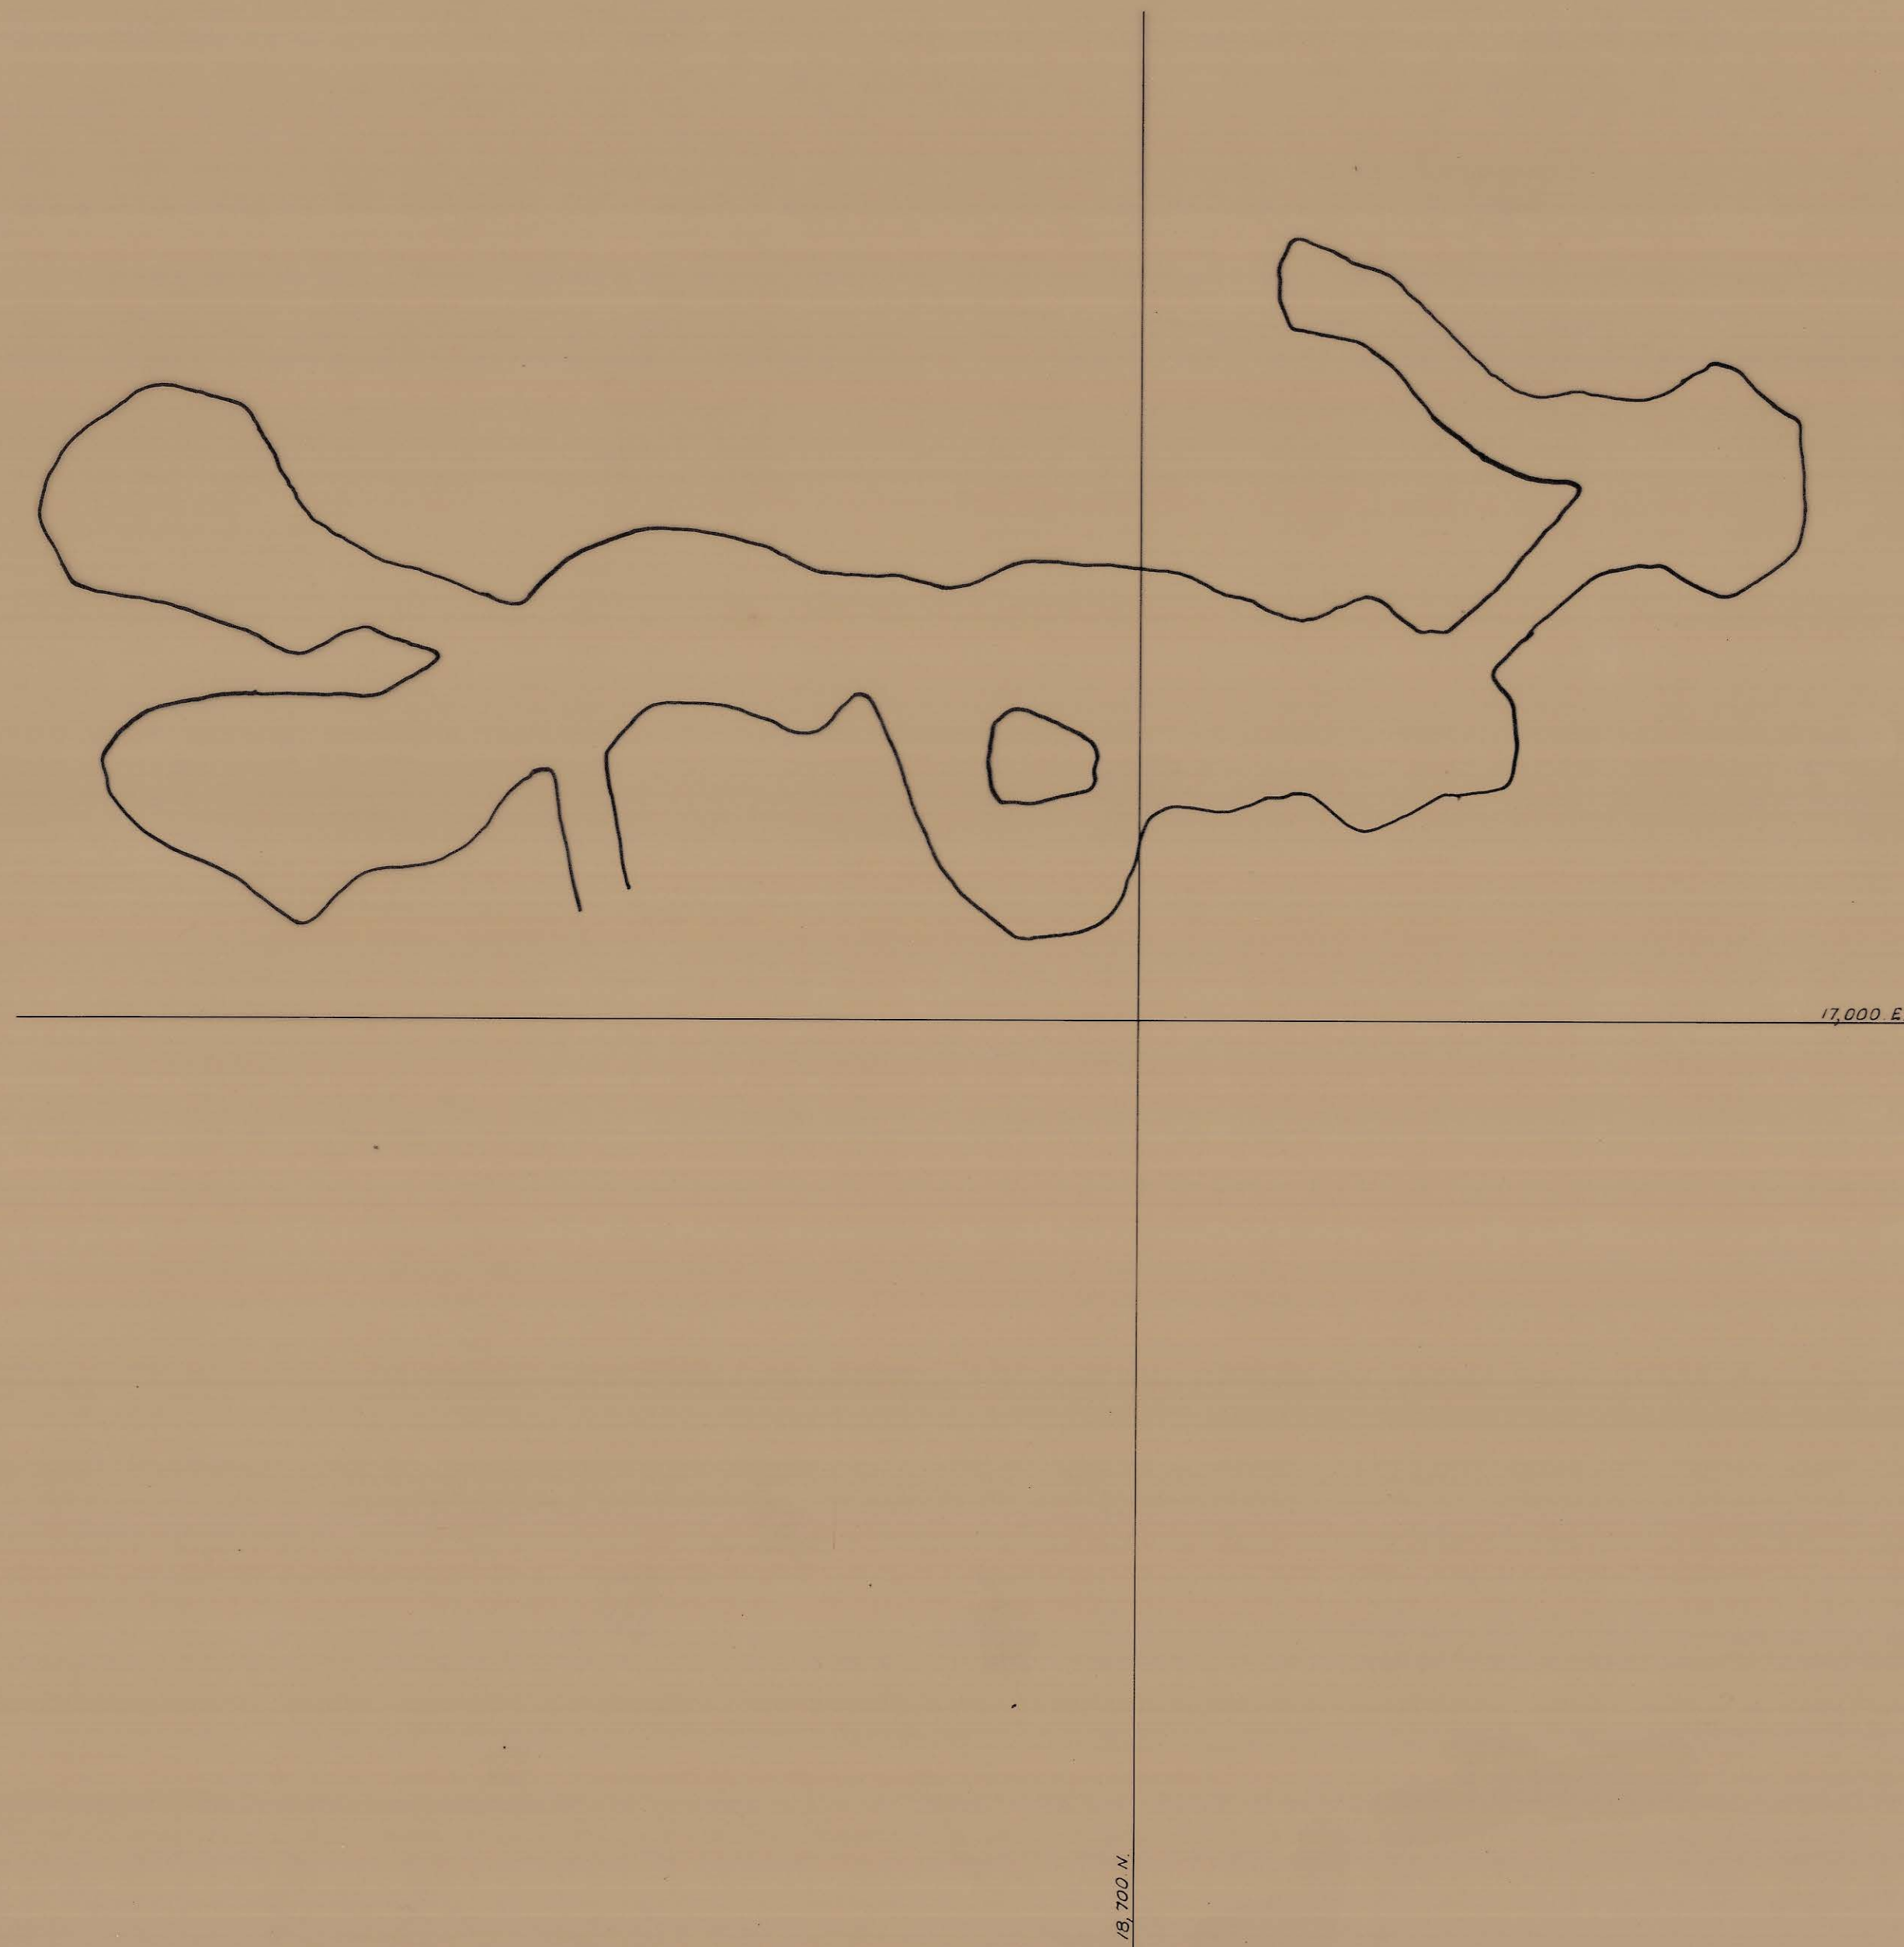

5 cm

DATE	MANAGER	SURVEYOR	RENISON LIMITED SURVEY			DRAWING NO
31-12-73	<i>[Signature]</i>	<i>[Signature]</i>	DRAWN: P.W.K.	DATE: 23-2-77	SCALE: 1:500	22-079
31-12-74	<i>[Signature]</i>	<i>[Signature]</i>				
31-12-75	<i>[Signature]</i>	<i>[Signature]</i>				
<i>[Signature]</i>			UPPER NORTH STEBBINS STOPE LEVEL: 2050.00			77071