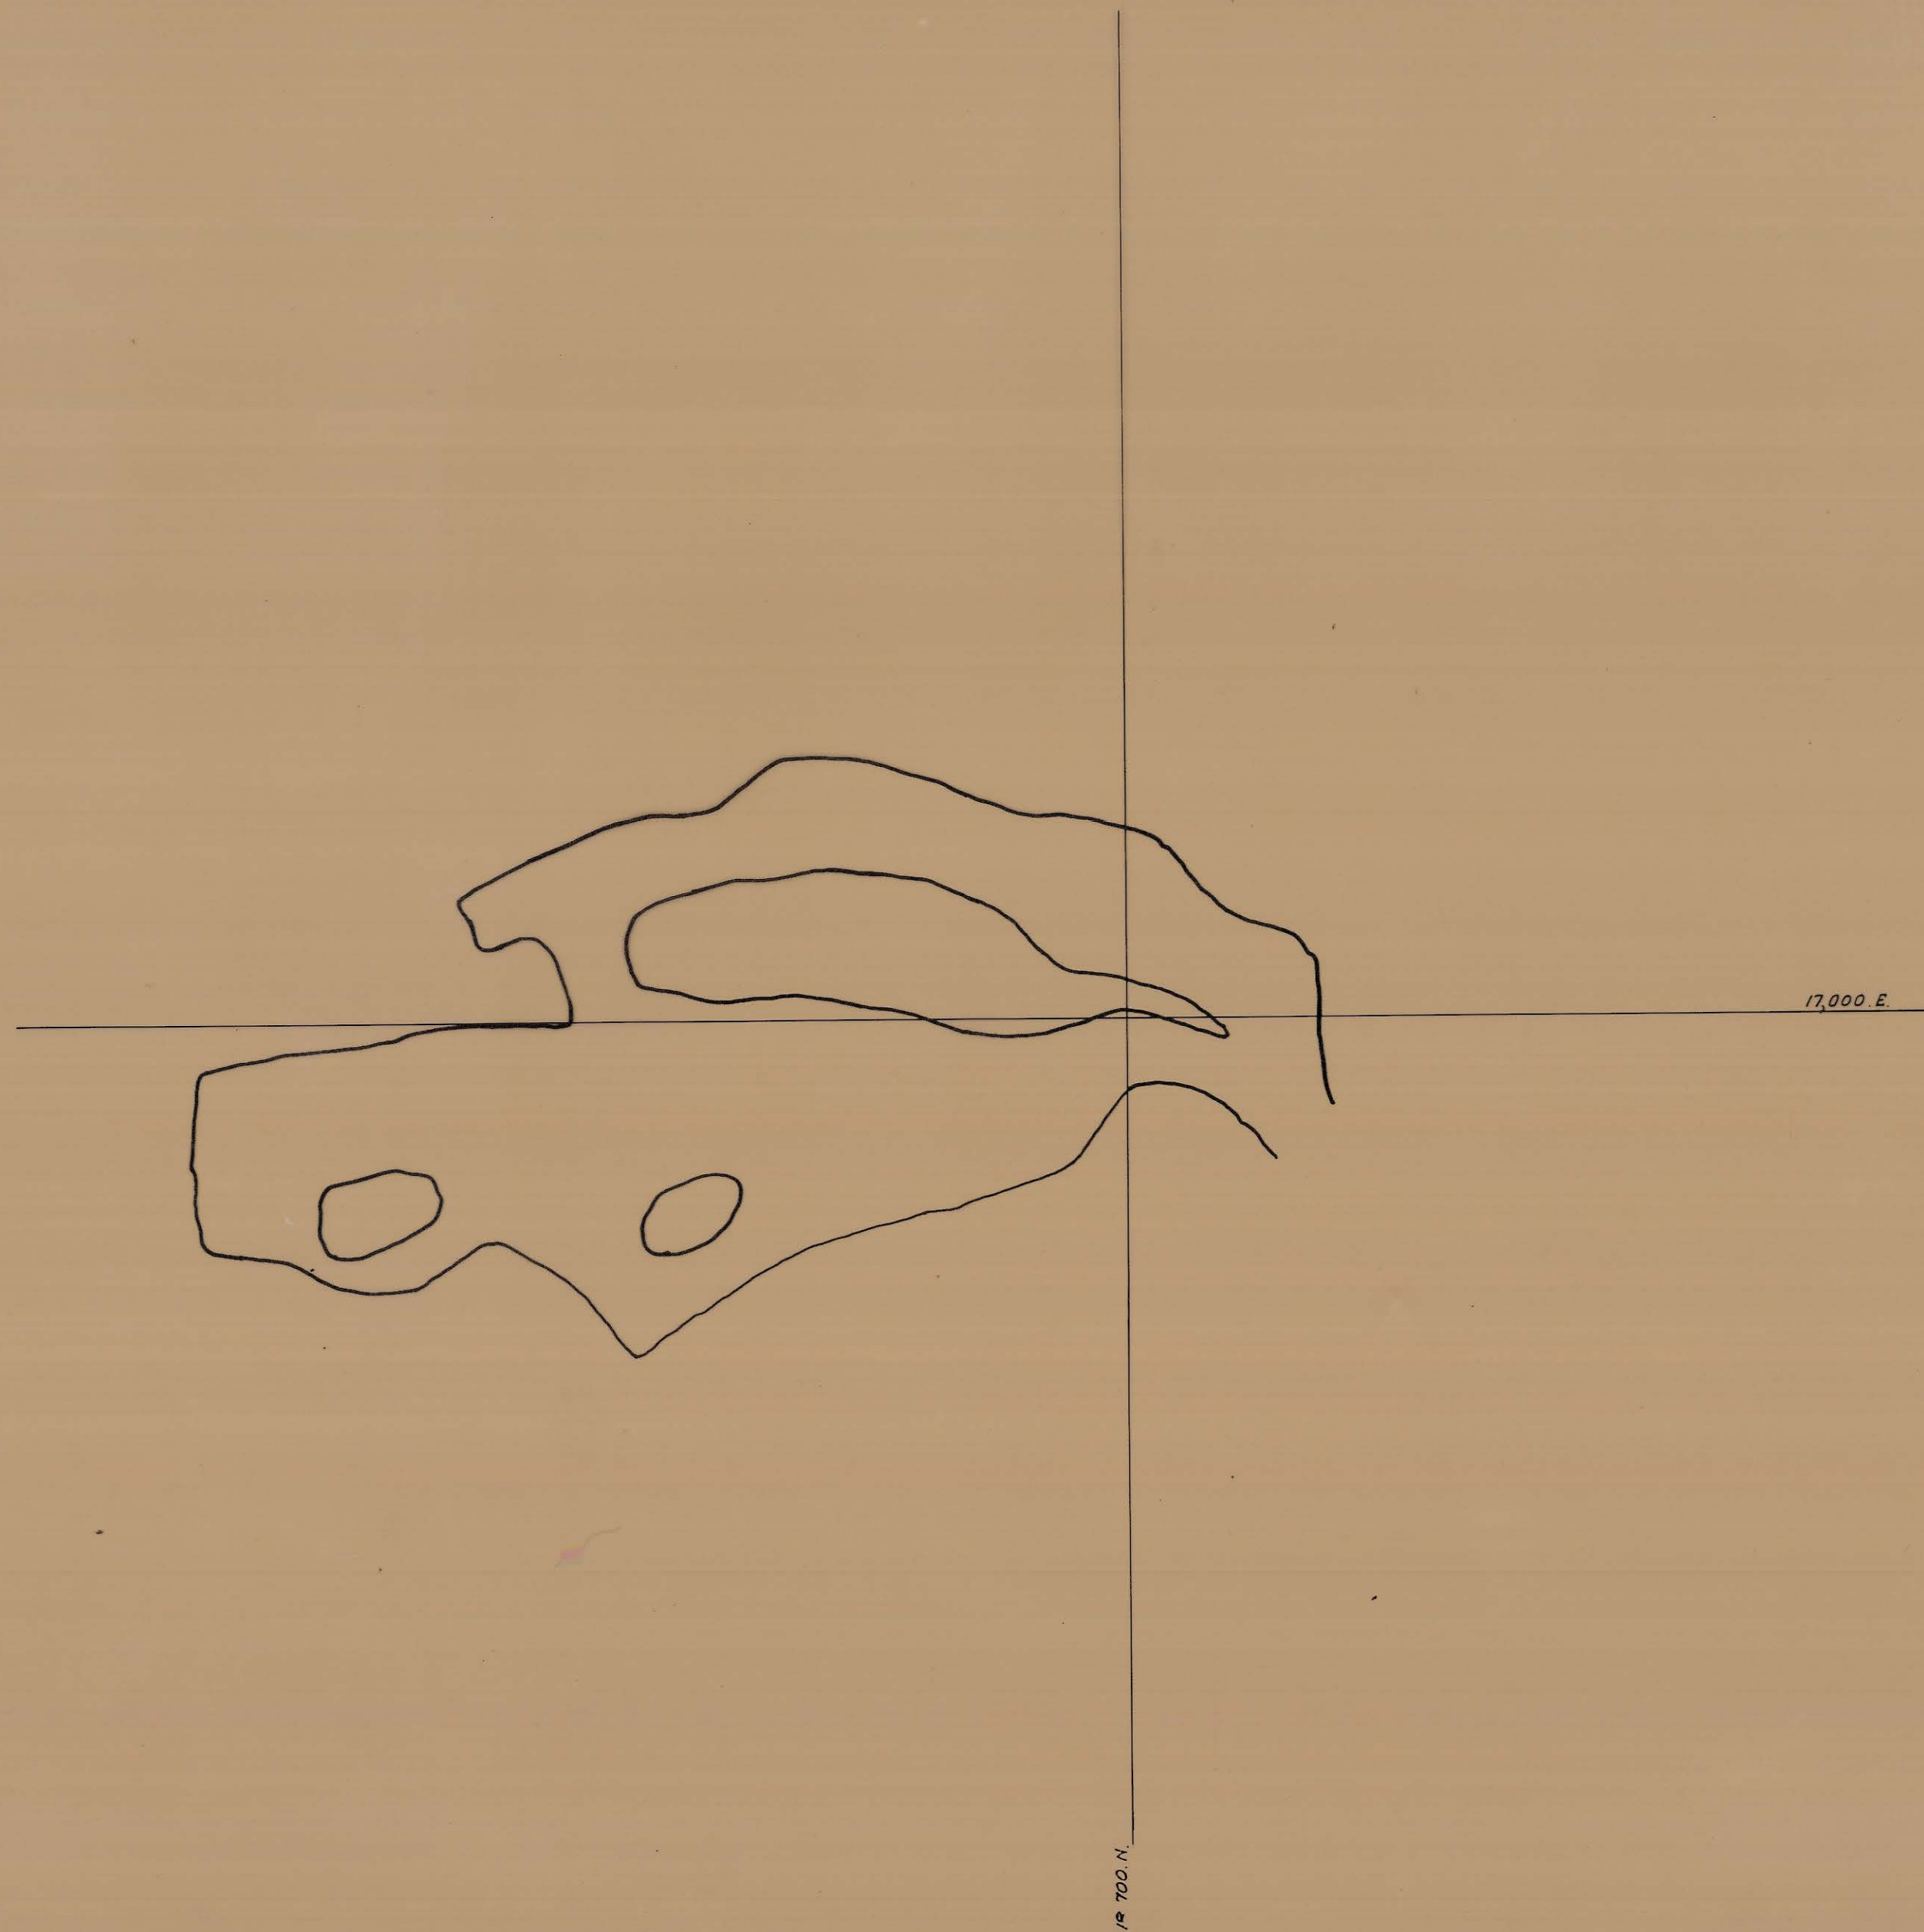


DATE	MANAGER	SURVEYOR	RENISON LIMITED SURVEY		DRAWING N°
31-12-73	<i>[Signature]</i>	<i>[Signature]</i>	DRAWN: P.W.K.	DATE: 23-2-73	22:079
31-12-74	<i>[Signature]</i>	<i>[Signature]</i>			
31-12-75	<i>[Signature]</i>	<i>[Signature]</i>			
31-12-76	<i>[Signature]</i>	<i>[Signature]</i>			
			UPPER NORTH STEBBINS STOPE LEVEL: 2070.00		77069

0376_567