



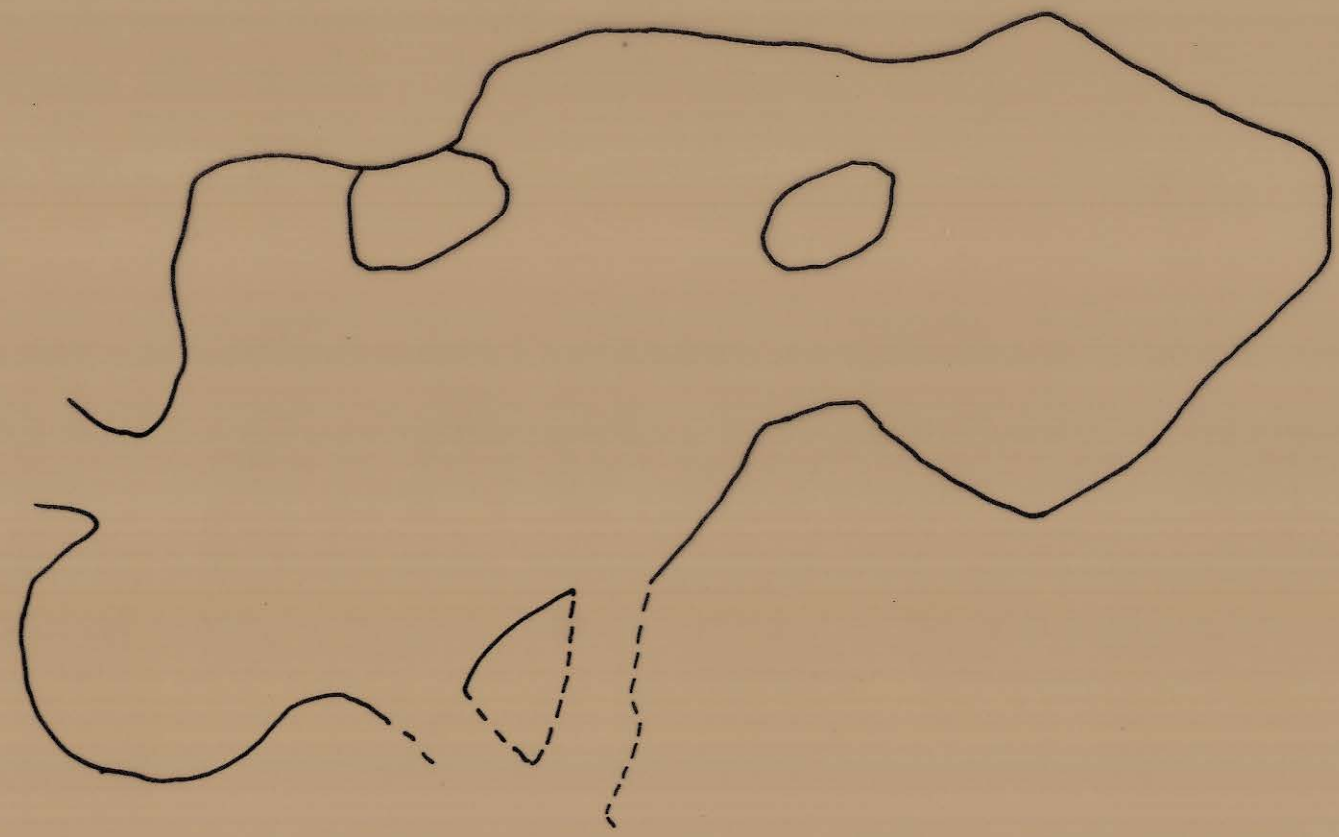

16,900. E.

18,800. N.

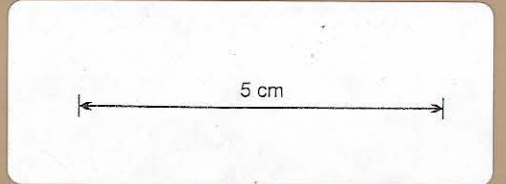

DATE	MANAGER	SURVEYOR	RENISON LIMITED SURVEY			DRAWING NO.
31-12-73	<i>[Signature]</i>	<i>[Signature]</i>	DRAWN: P.W.K.	DATE: 26-2-73	SCALE: 1:500	22:079
31-12-74	<i>[Signature]</i>	<i>[Signature]</i>				
31-12-75	<i>[Signature]</i>	<i>[Signature]</i>				
			UPPER NORTH STEBBINS STOPE LEVEL: 2080.00			77068