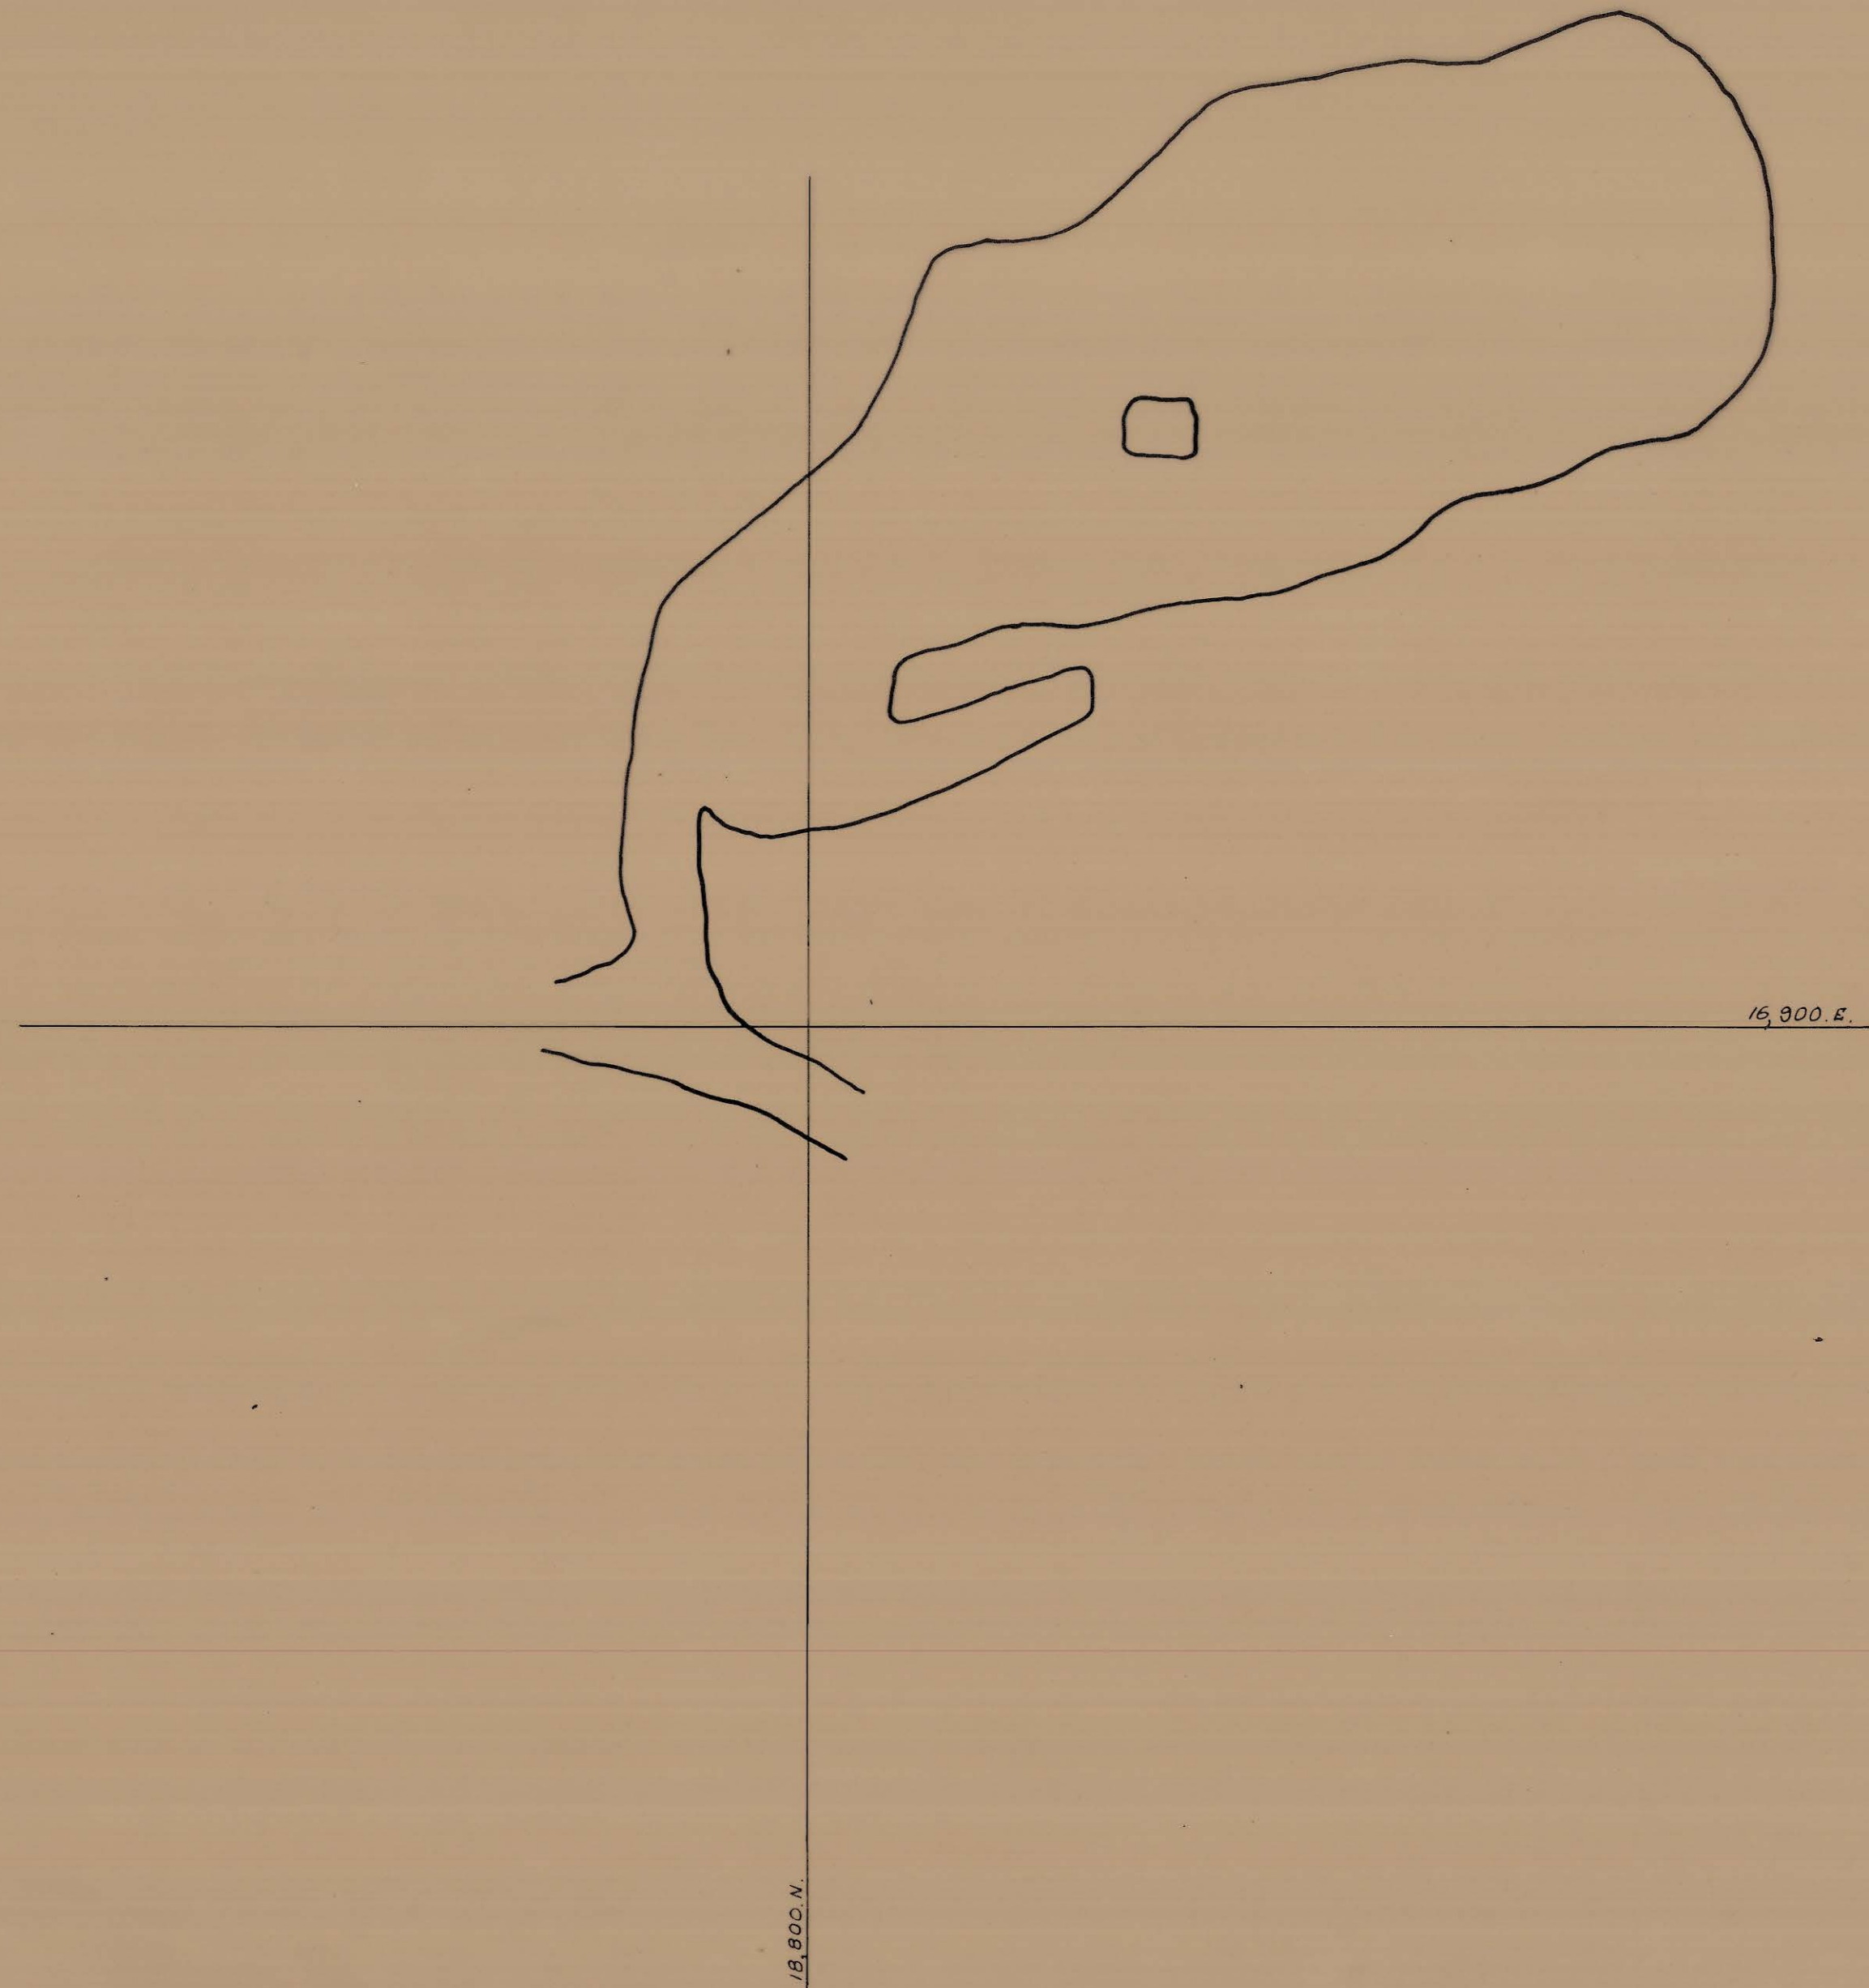


DATE	MANAGER	SURVEYOR	RENISON LIMITED SURVEY			DRAWING NO
31-12-73	<i>[Signature]</i>	<i>[Signature]</i>	DRAWN: P.W.K.	DATE: 26.2.73	SCALE: 1:500	22:079
31-12-74	<i>[Signature]</i>	<i>[Signature]</i>				
31-12-75	<i>[Signature]</i>	<i>[Signature]</i>				
2-10-76	<i>[Signature]</i>	<i>[Signature]</i>	UPPER NORTH STEBBINS STOPE LEVEL: 2090.00			77067