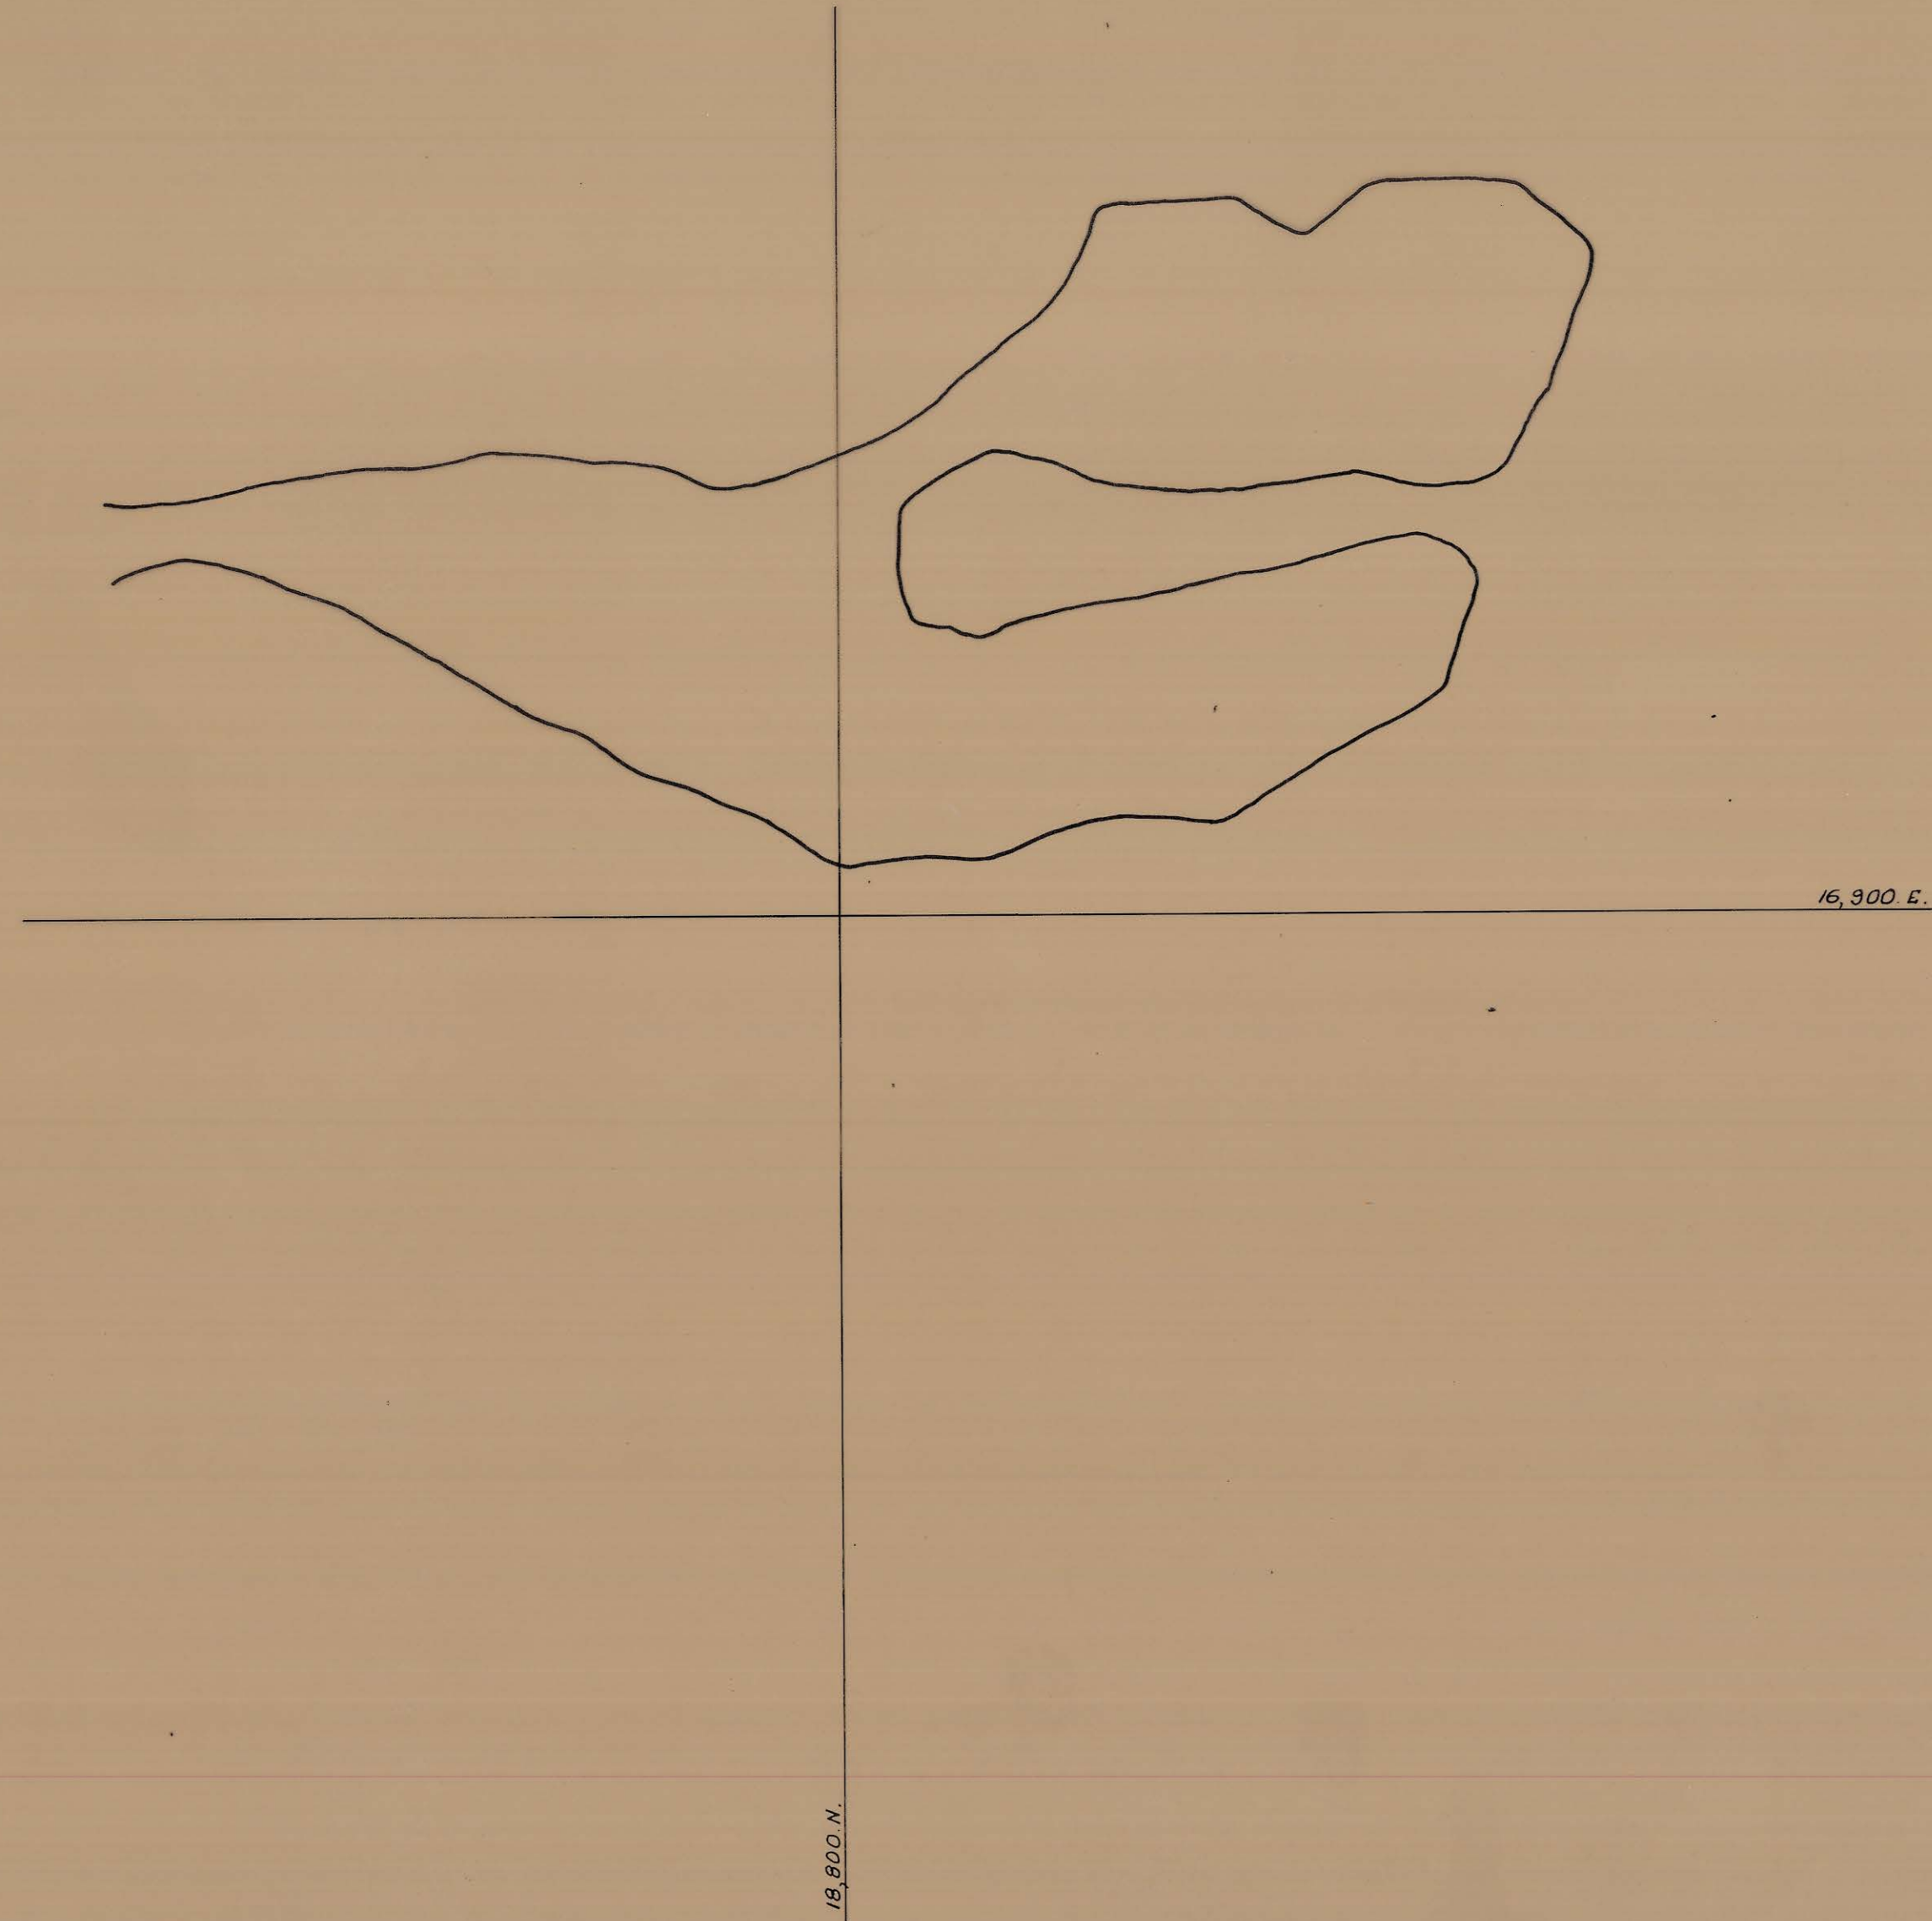


DATE	MANAGER	SURVEYOR	RENISON LIMITED SURVEY			DRAWING NO
31-12-73	<i>G. H. Hutton</i>	<i>M. A. H.</i>	DRAWN : P.W.K. DATE : 26.2.73 SCALE : 1:500	UPPER NORTH STEBBINS STOPE LEVEL : 2100.00		22:079 77066
31-12-74	<i>E. H. Hutton</i>	<i>M. A. H.</i>				
31-12-75	<i>U.K. Hutton</i>	<i>M. A. H.</i>				
31-12-76	<i>U.K. Hutton</i>	<i>M. A. H.</i>				