


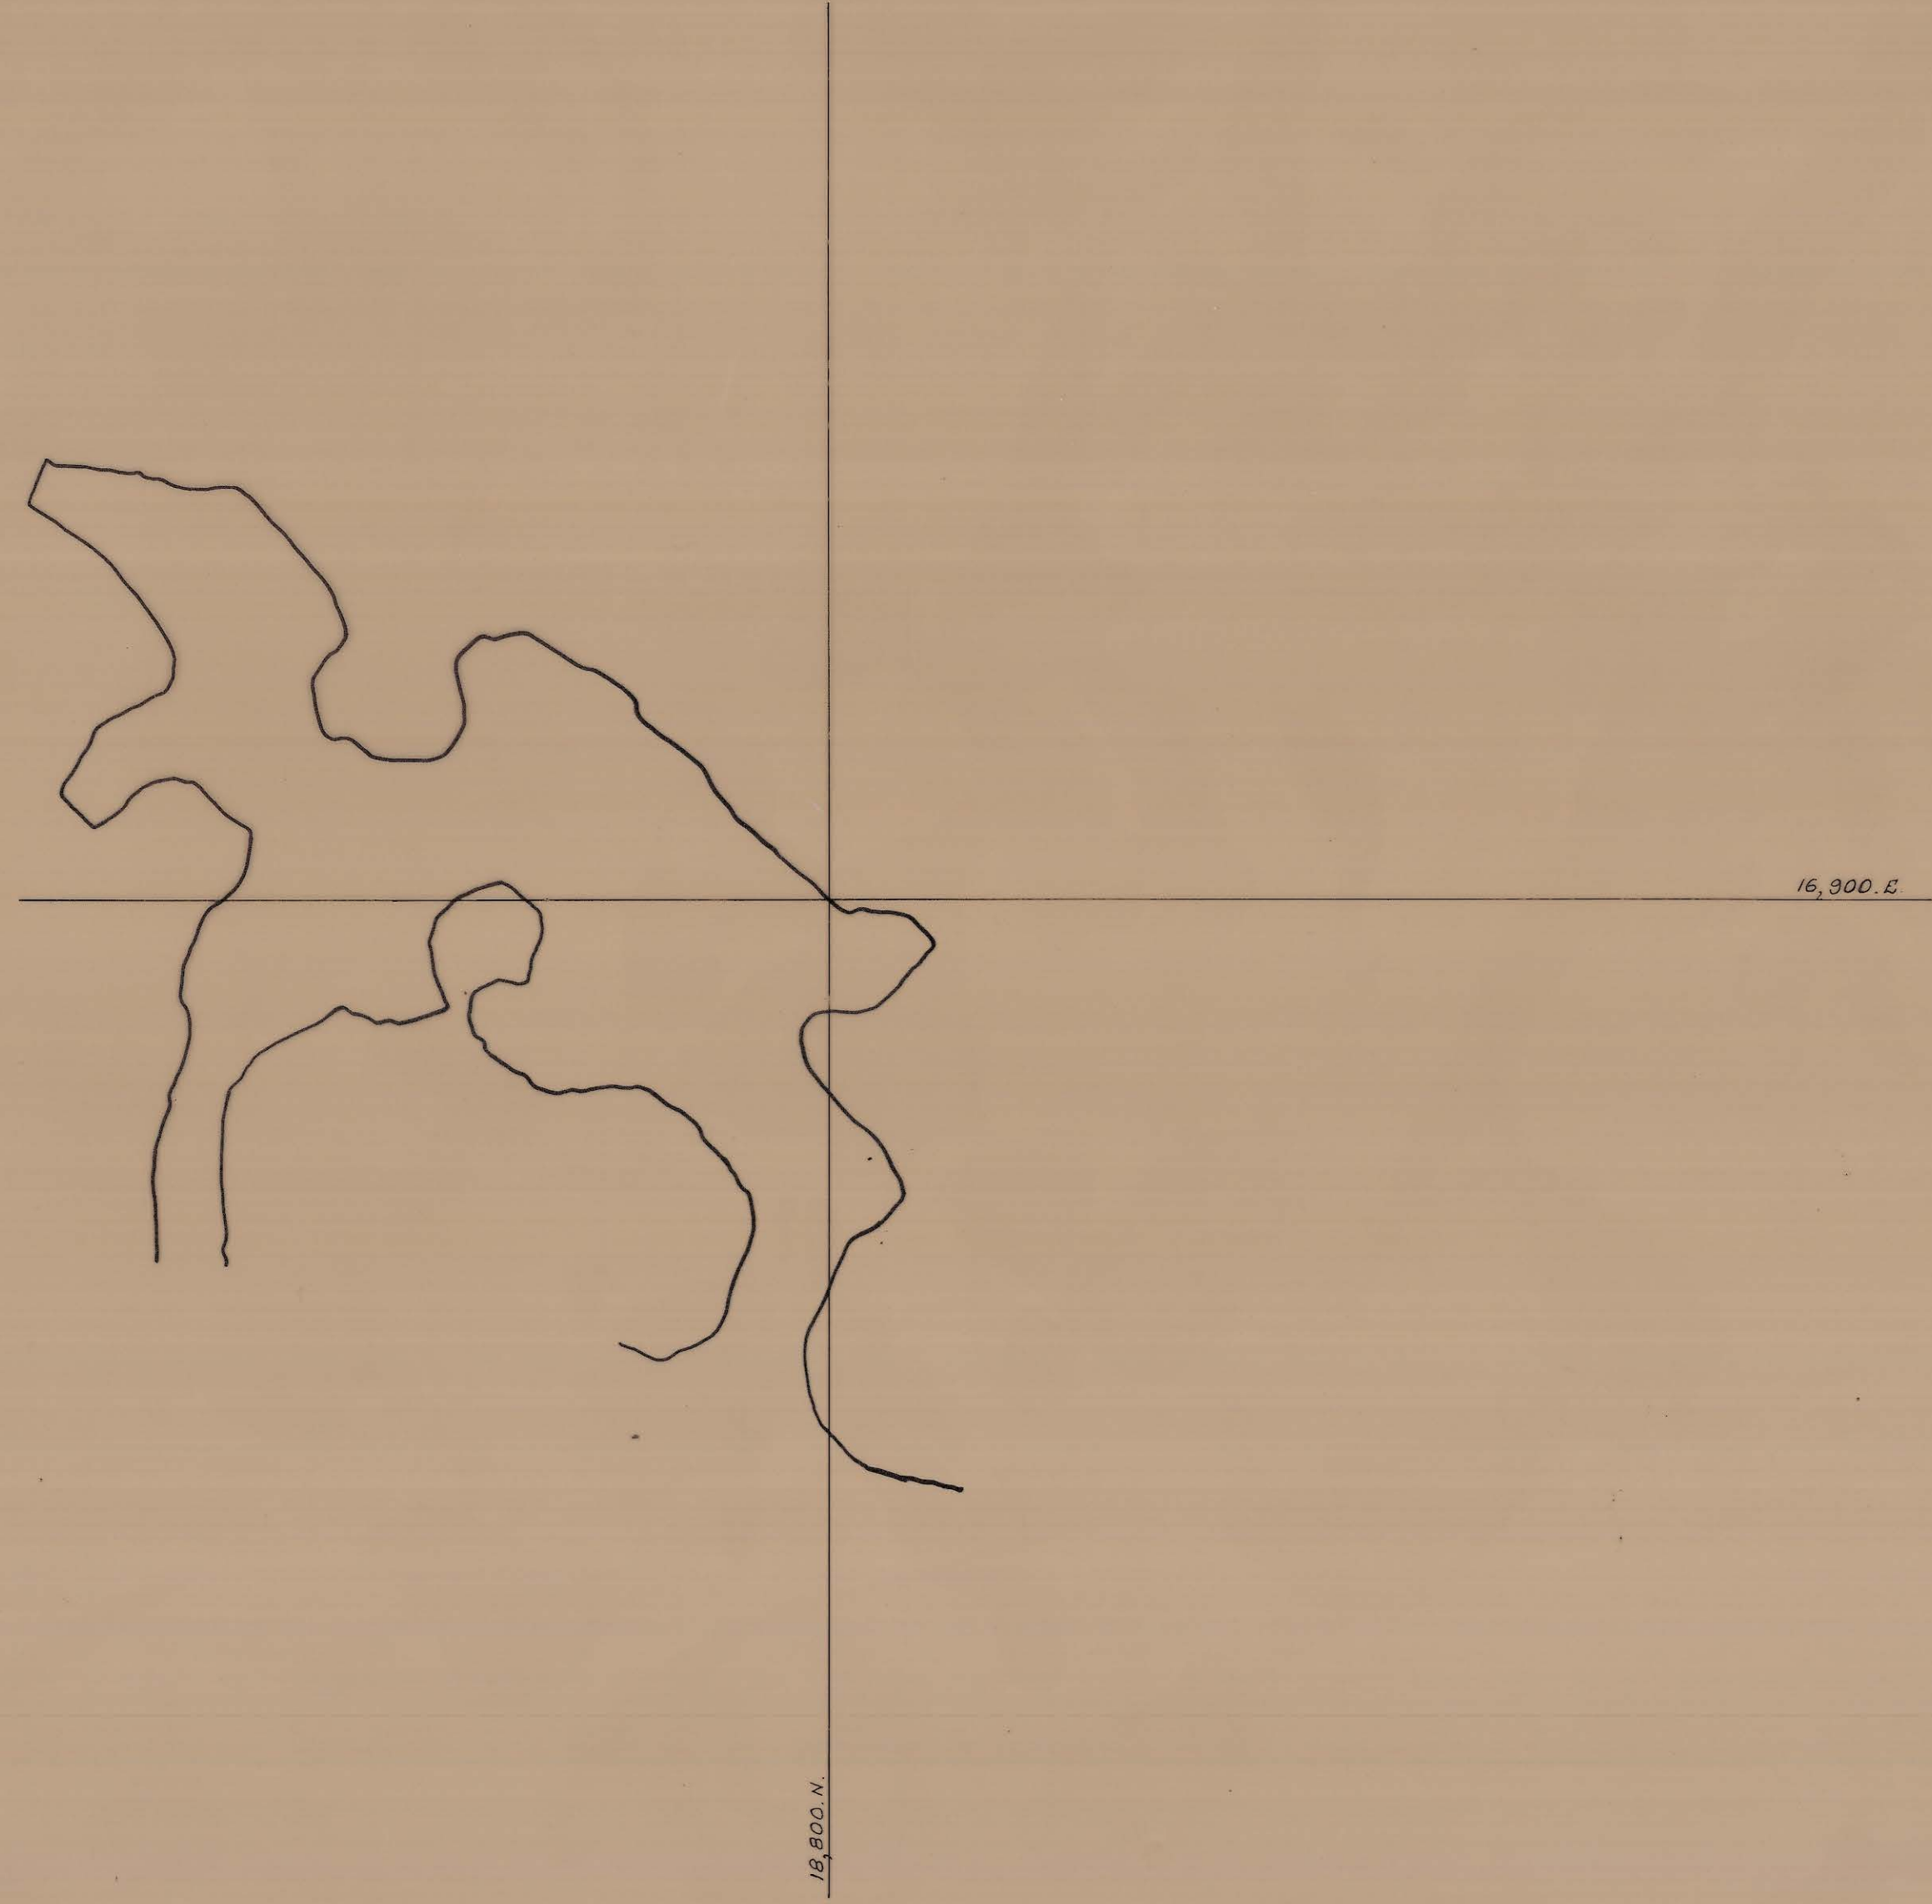

5 cm

DATE			MANAGER			SURVEYOR			RENISON LIMITED SURVEY			DRAWING N°		
31-12-73			W. Hamilton			W. Hamilton			DRAWN: P.W.K. DATE: 26.2.73 SCALE: 1:500			22:079		
31-12-74			W. Hamilton			W. Hamilton								
31-12-75			W. Hamilton			W. Hamilton								
31-12-76			W. Hamilton			W. Hamilton								
UPPER NORTH STEBBINS STOPE LEVEL: 2115.00												77064		