


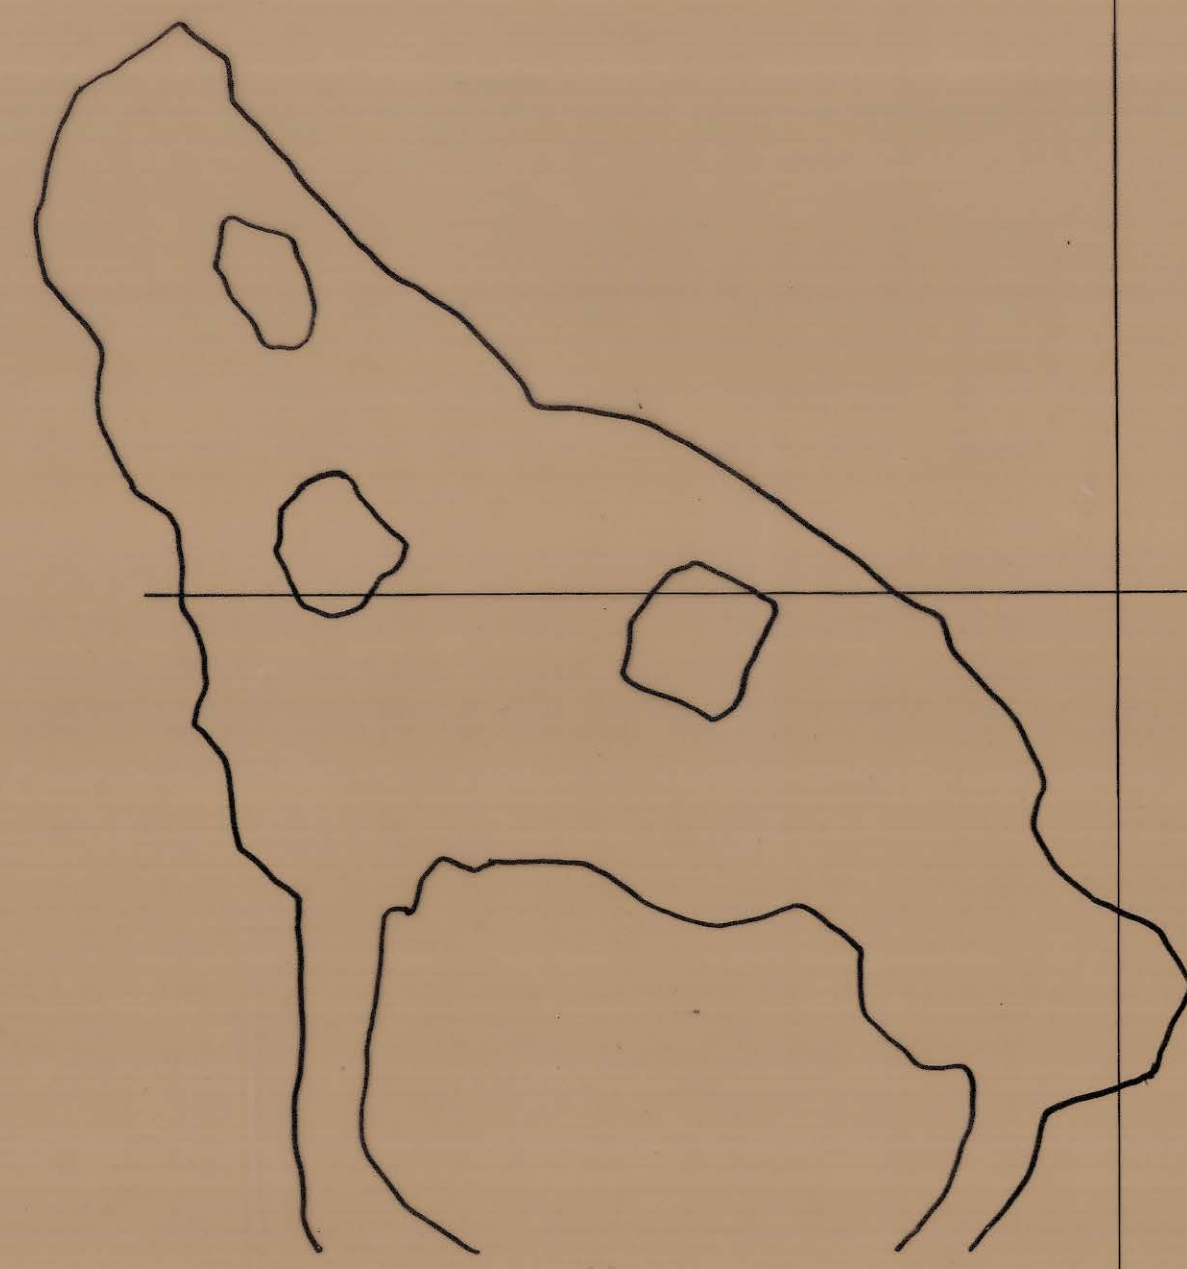

18,800 N.

16,900 E.

5 cm

DATE	MANAGER	SURVEYOR	RENISON LIMITED SURVEY			DRAWING NO
31-12-73	<i>[Signature]</i>	<i>[Signature]</i>	DRAWN: P.W.K. DATE: 7.3.74 SCALE: 1:500 UPPER NORTH STEBBINS STOPE LEVEL: 2120.00			22:079 77063
31-12-74	<i>[Signature]</i>	<i>[Signature]</i>				
31-12-75	<i>[Signature]</i>	<i>[Signature]</i>				
31-12-76	<i>[Signature]</i>	<i>[Signature]</i>				