




18.800 N

16.900 E

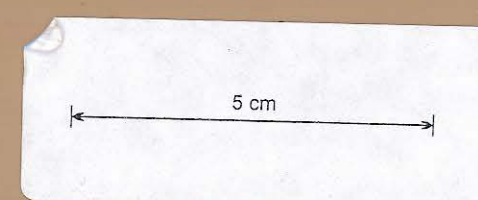

DATE		MANAGER	SURVEYOR	RENISON LIMITED			DRAWING No.
				SURVEY			
31-12-74	<i>W. J. ...</i>	<i>W. J. ...</i>		DRAWN. A. J. M.	DATE: 3.10.74	SCALE: 1: 500	22: 079
31-12-75	<i>W. J. ...</i>	<i>W. J. ...</i>		UPPER NORTH STEBBINS STOPE			
31-12-76	<i>W. J. ...</i>	<i>W. J. ...</i>		LEVEL 2129			77061