




18800 N

16900 E

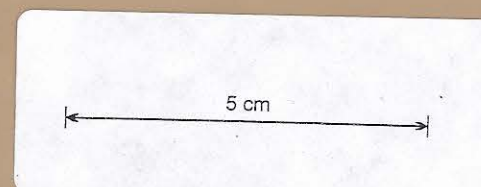

DATE	MANAGER	SURVEYOR	RENISON LIMITED SURVEY.		DRAWING No.
31-12-75	<i>[Signature]</i>	<i>[Signature]</i>			
31-12-76	<i>[Signature]</i>	<i>[Signature]</i>	DRAWN: F.M.H.	DATE: 10-12-75 SCALE: 1:500	
			UPPER NORTH STEBBINS STOPE.		22:079
			FILL LEVEL: 2135.		77060

0376_576