


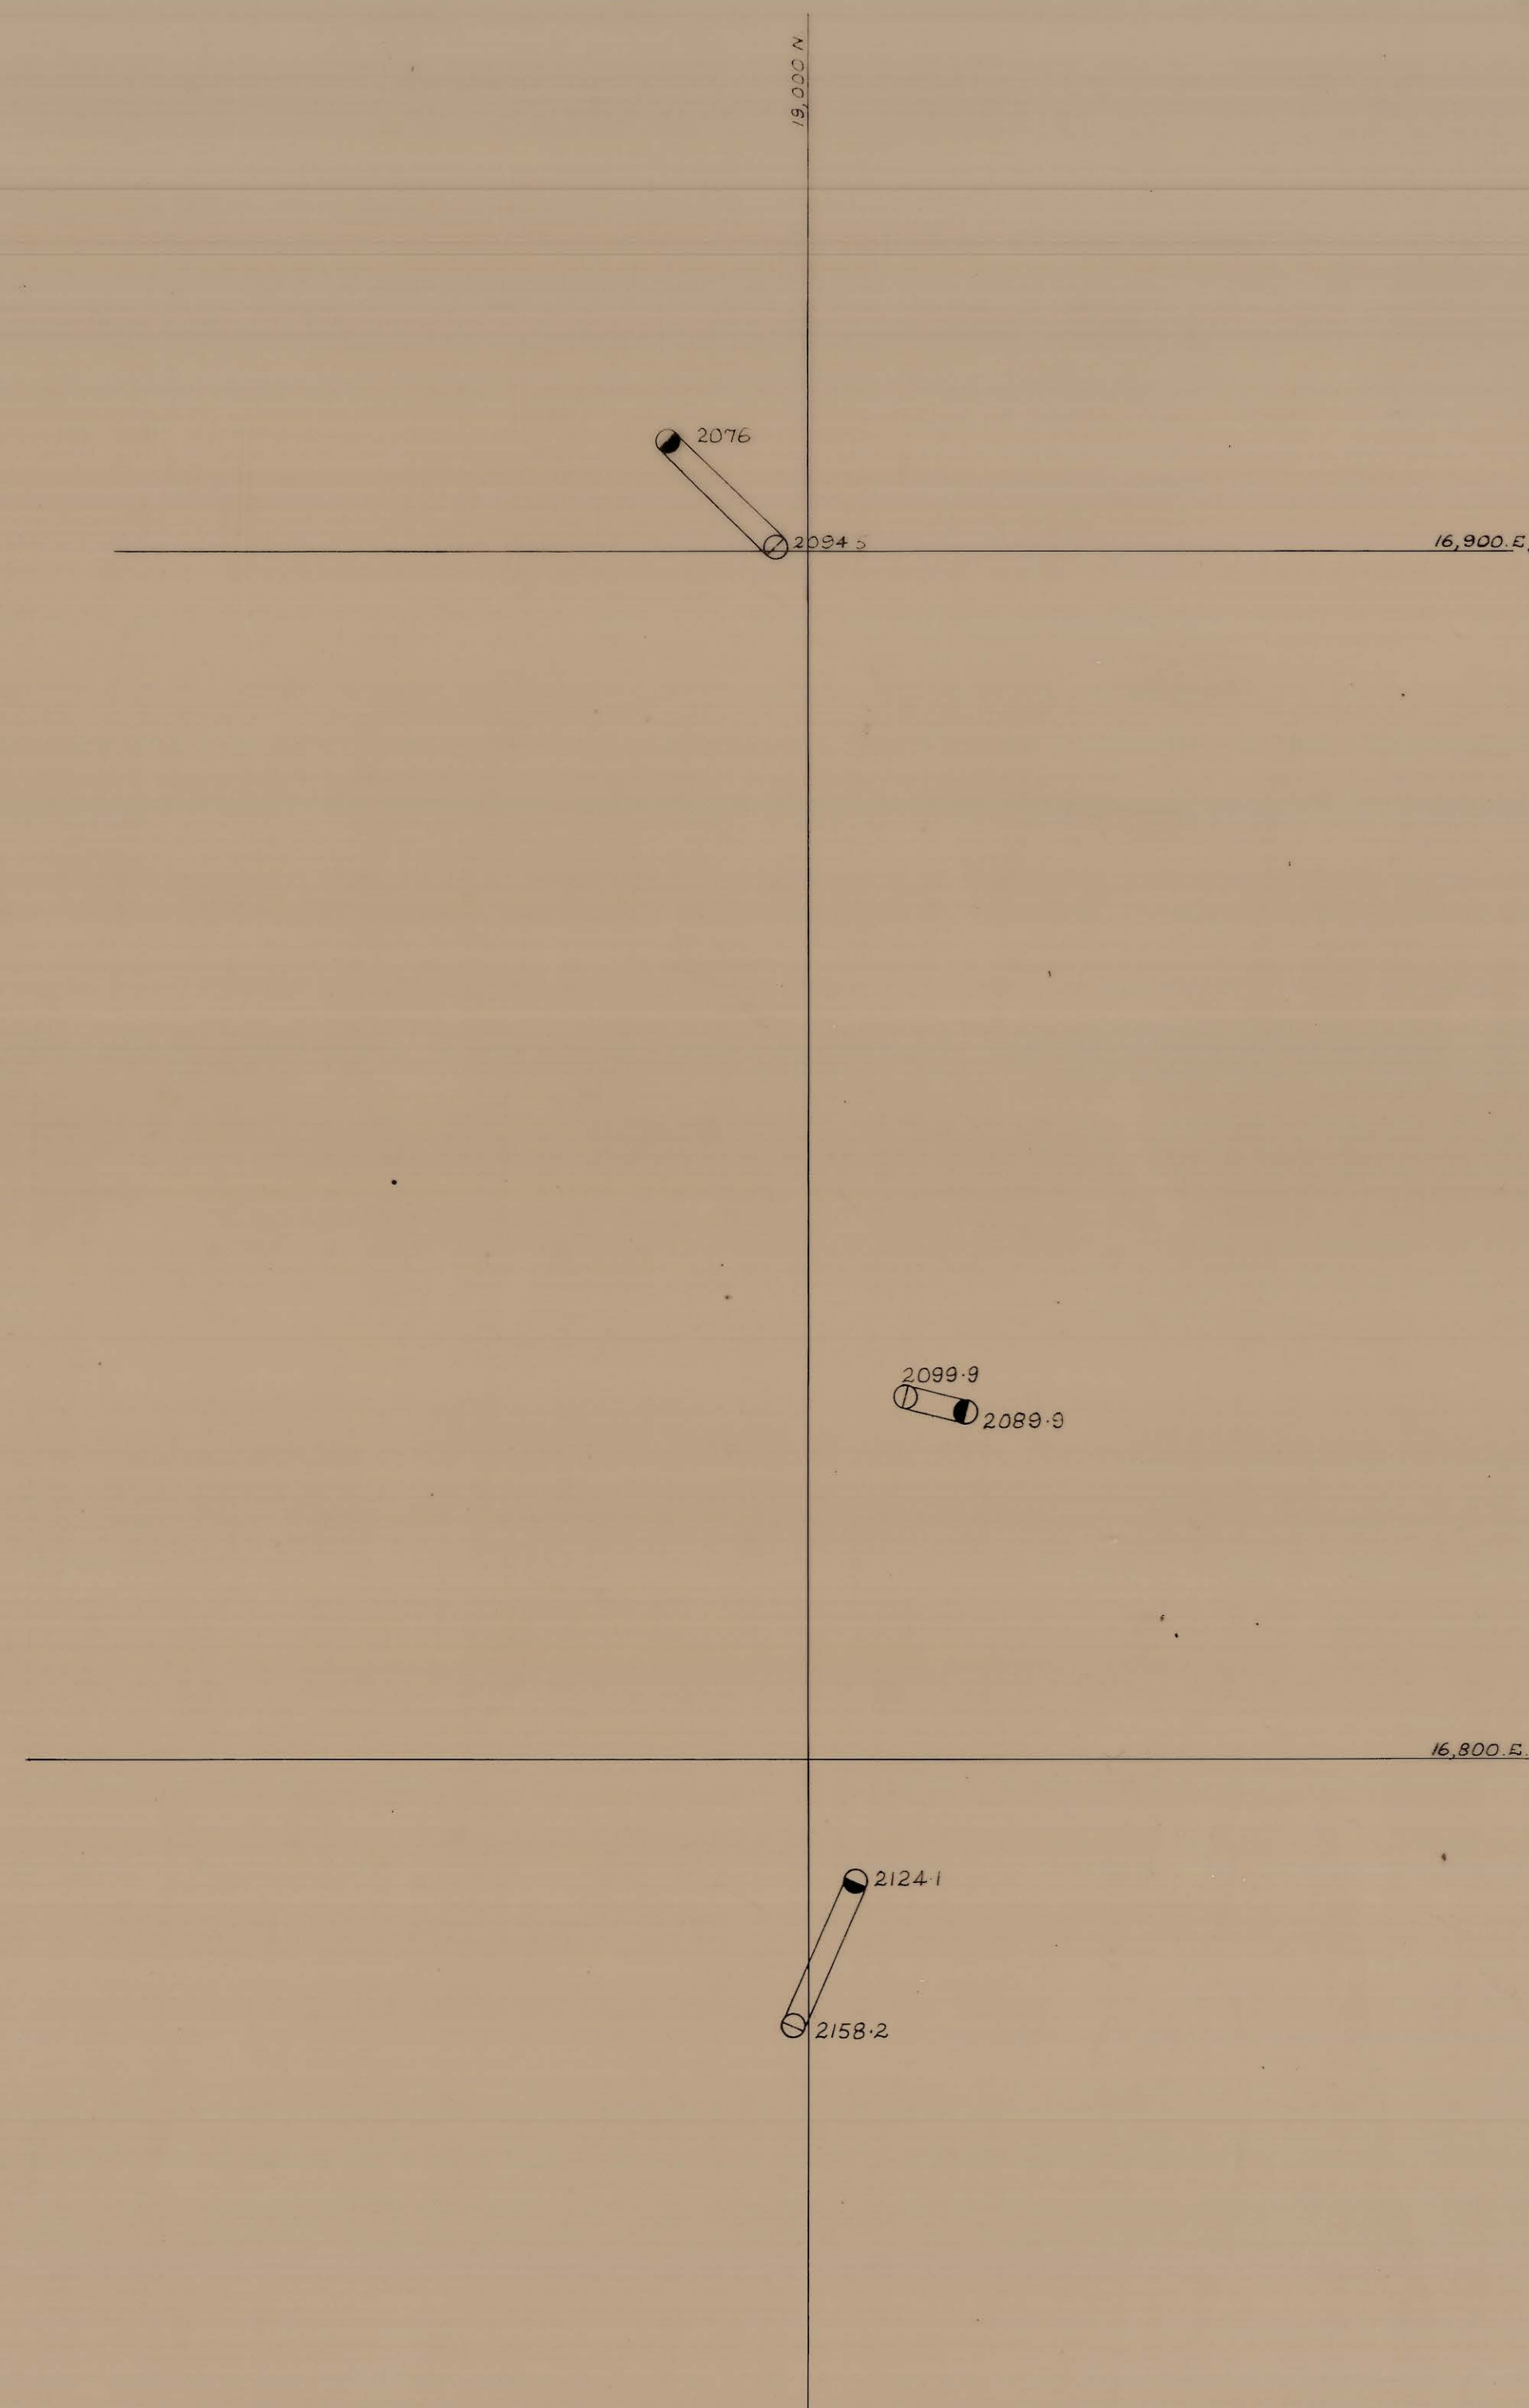

5 cm

DATE	MANAGER	SURVEYOR	RENISON LIMITED SURVEY		DRAWING N°
31-12-73	<i>[Signature]</i>	<i>[Signature]</i>	LOWER DREADNOUGHT STOPE Rises		17-001 77-059
31-12-74	<i>[Signature]</i>	<i>[Signature]</i>			
31-12-75	<i>[Signature]</i>	<i>[Signature]</i>			
31-12-76	<i>[Signature]</i>	<i>[Signature]</i>			
DRAWN: P.W.K.			DATE: 8-3-73	SCALE: 1:500	