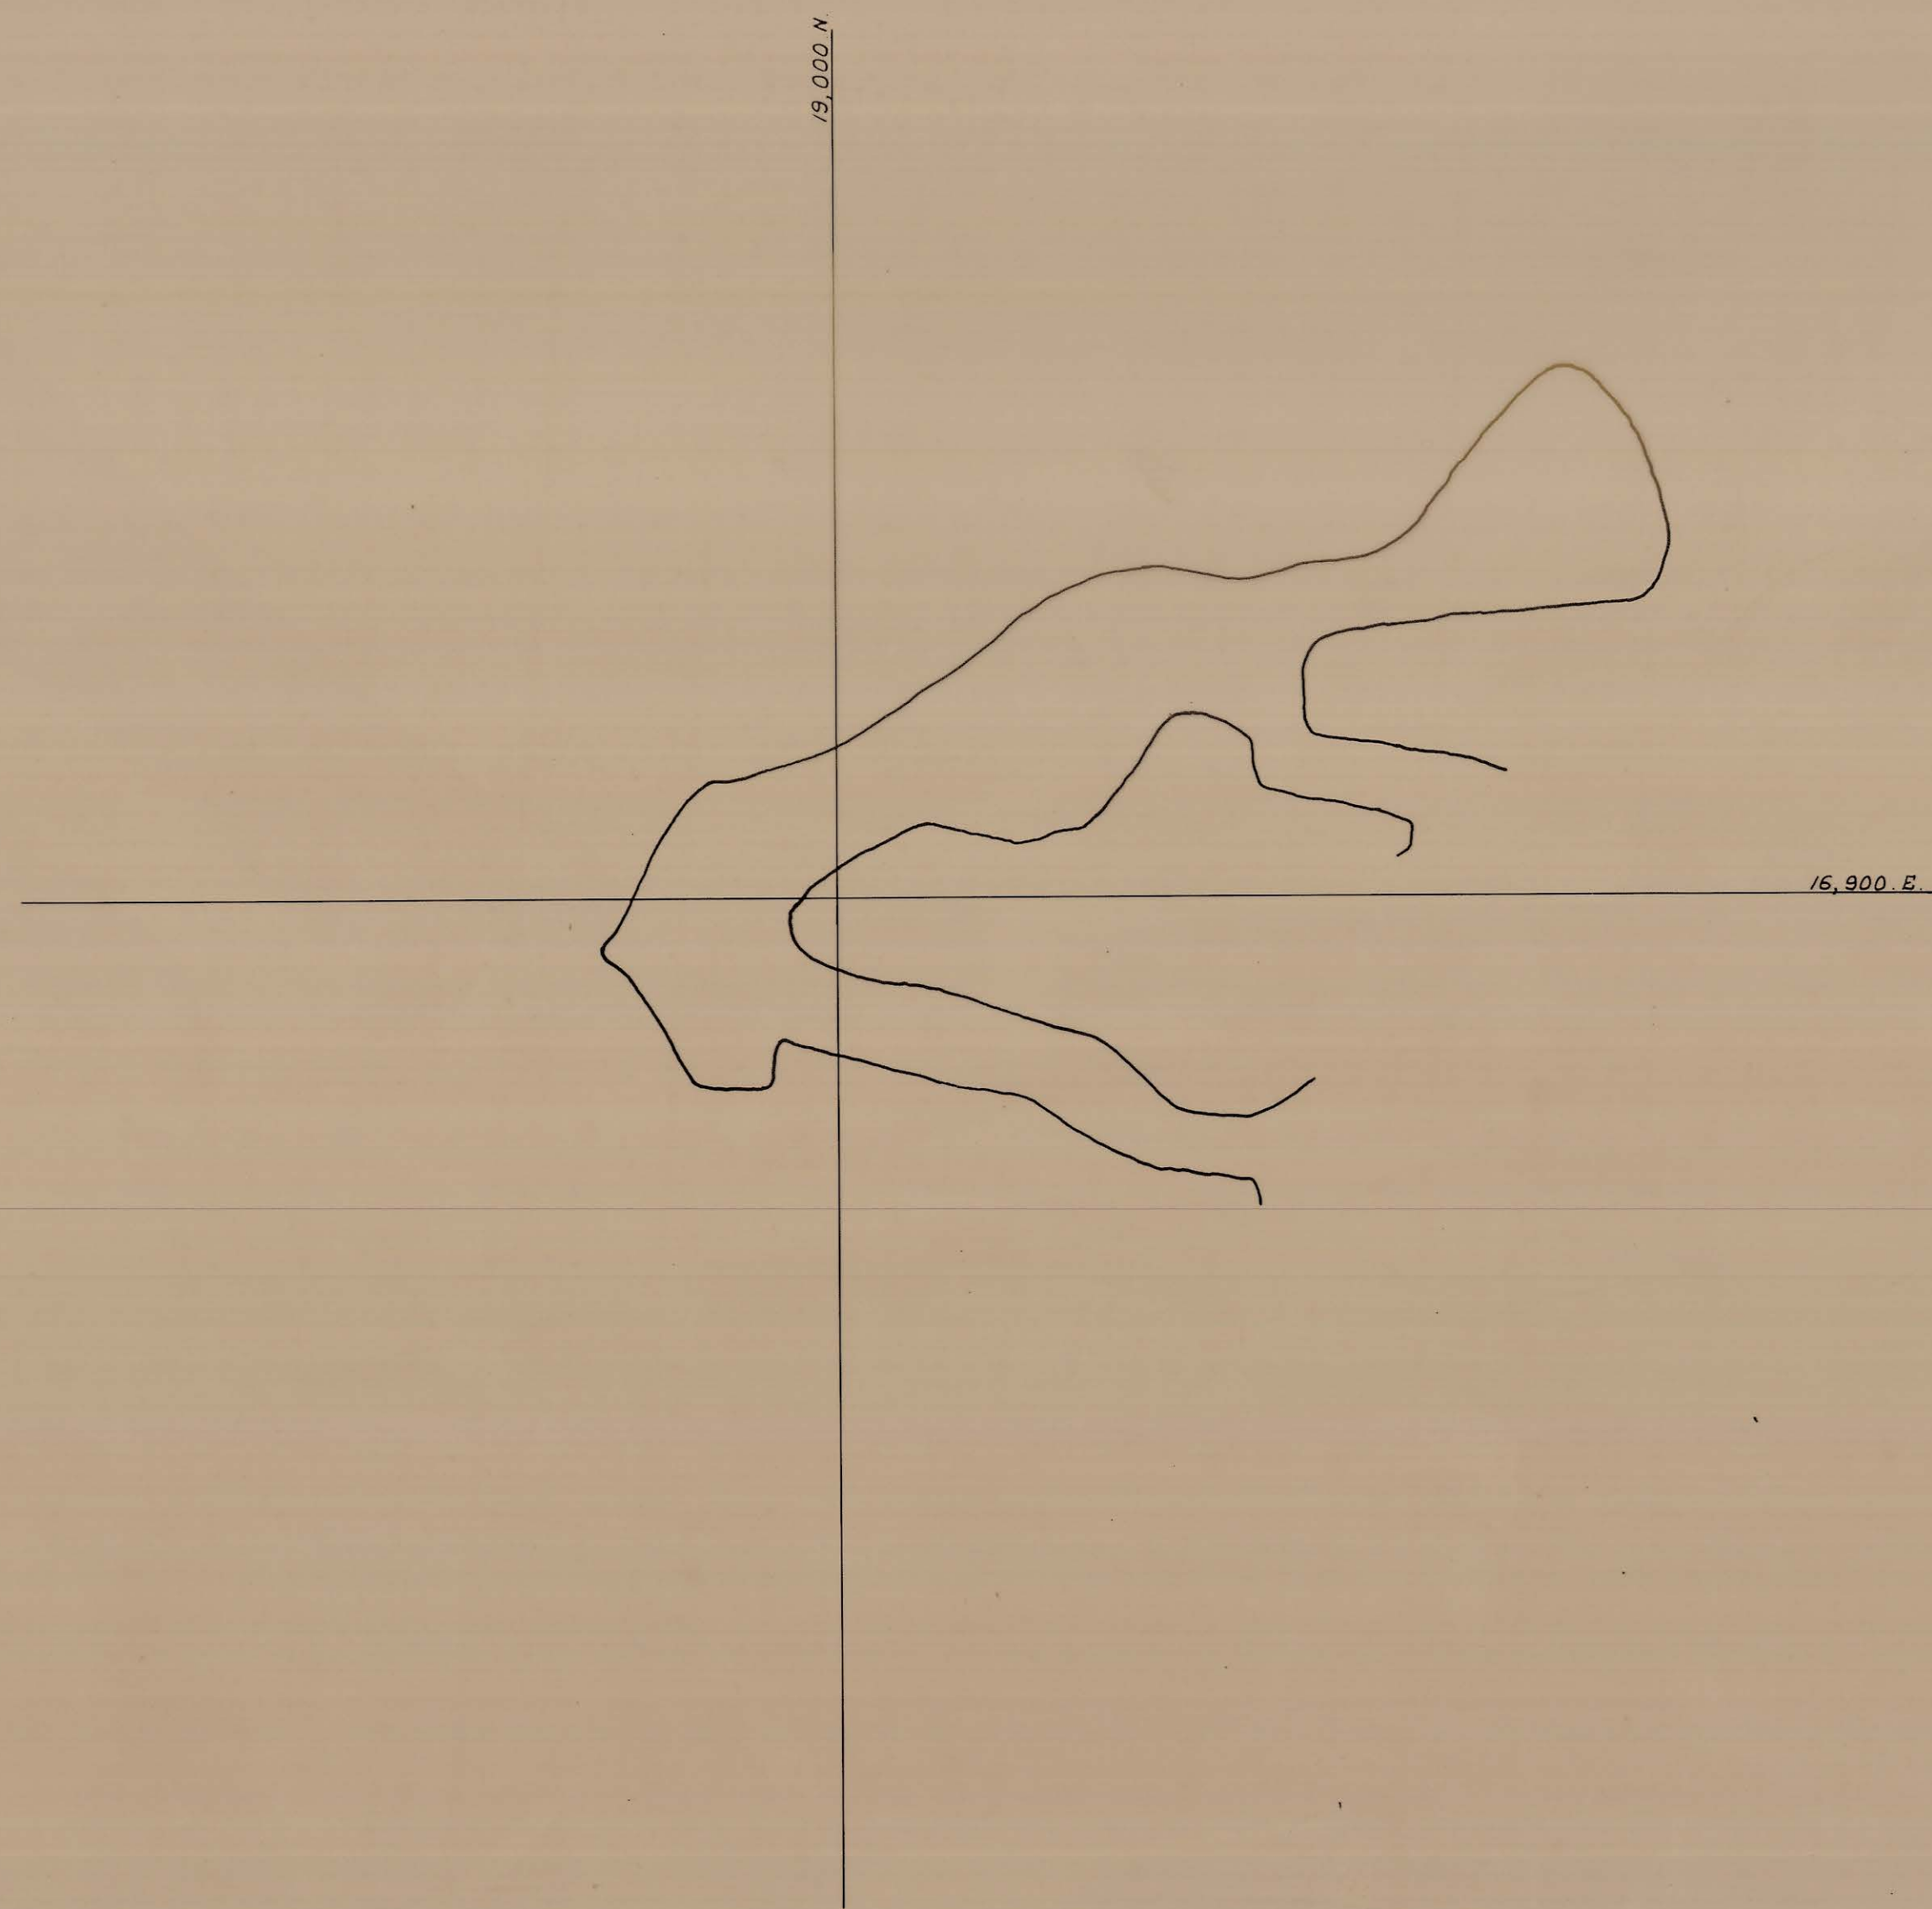


DATE	MANAGER	SURVEYOR	RENISON LIMITED SURVEY			DRAWING N°
31-12-73	<i>[Signature]</i>	<i>[Signature]</i>	DRAWN: P.W.K.	DATE: 22-3-73	SCALE: 1:500	17:001
31-12-74	<i>[Signature]</i>	<i>[Signature]</i>				
31-12-75	<i>[Signature]</i>	<i>[Signature]</i>				
31-12-76	<i>[Signature]</i>	<i>[Signature]</i>				
			LOWER DREADNOUGHT STOPE LEVEL 2083			77-056