


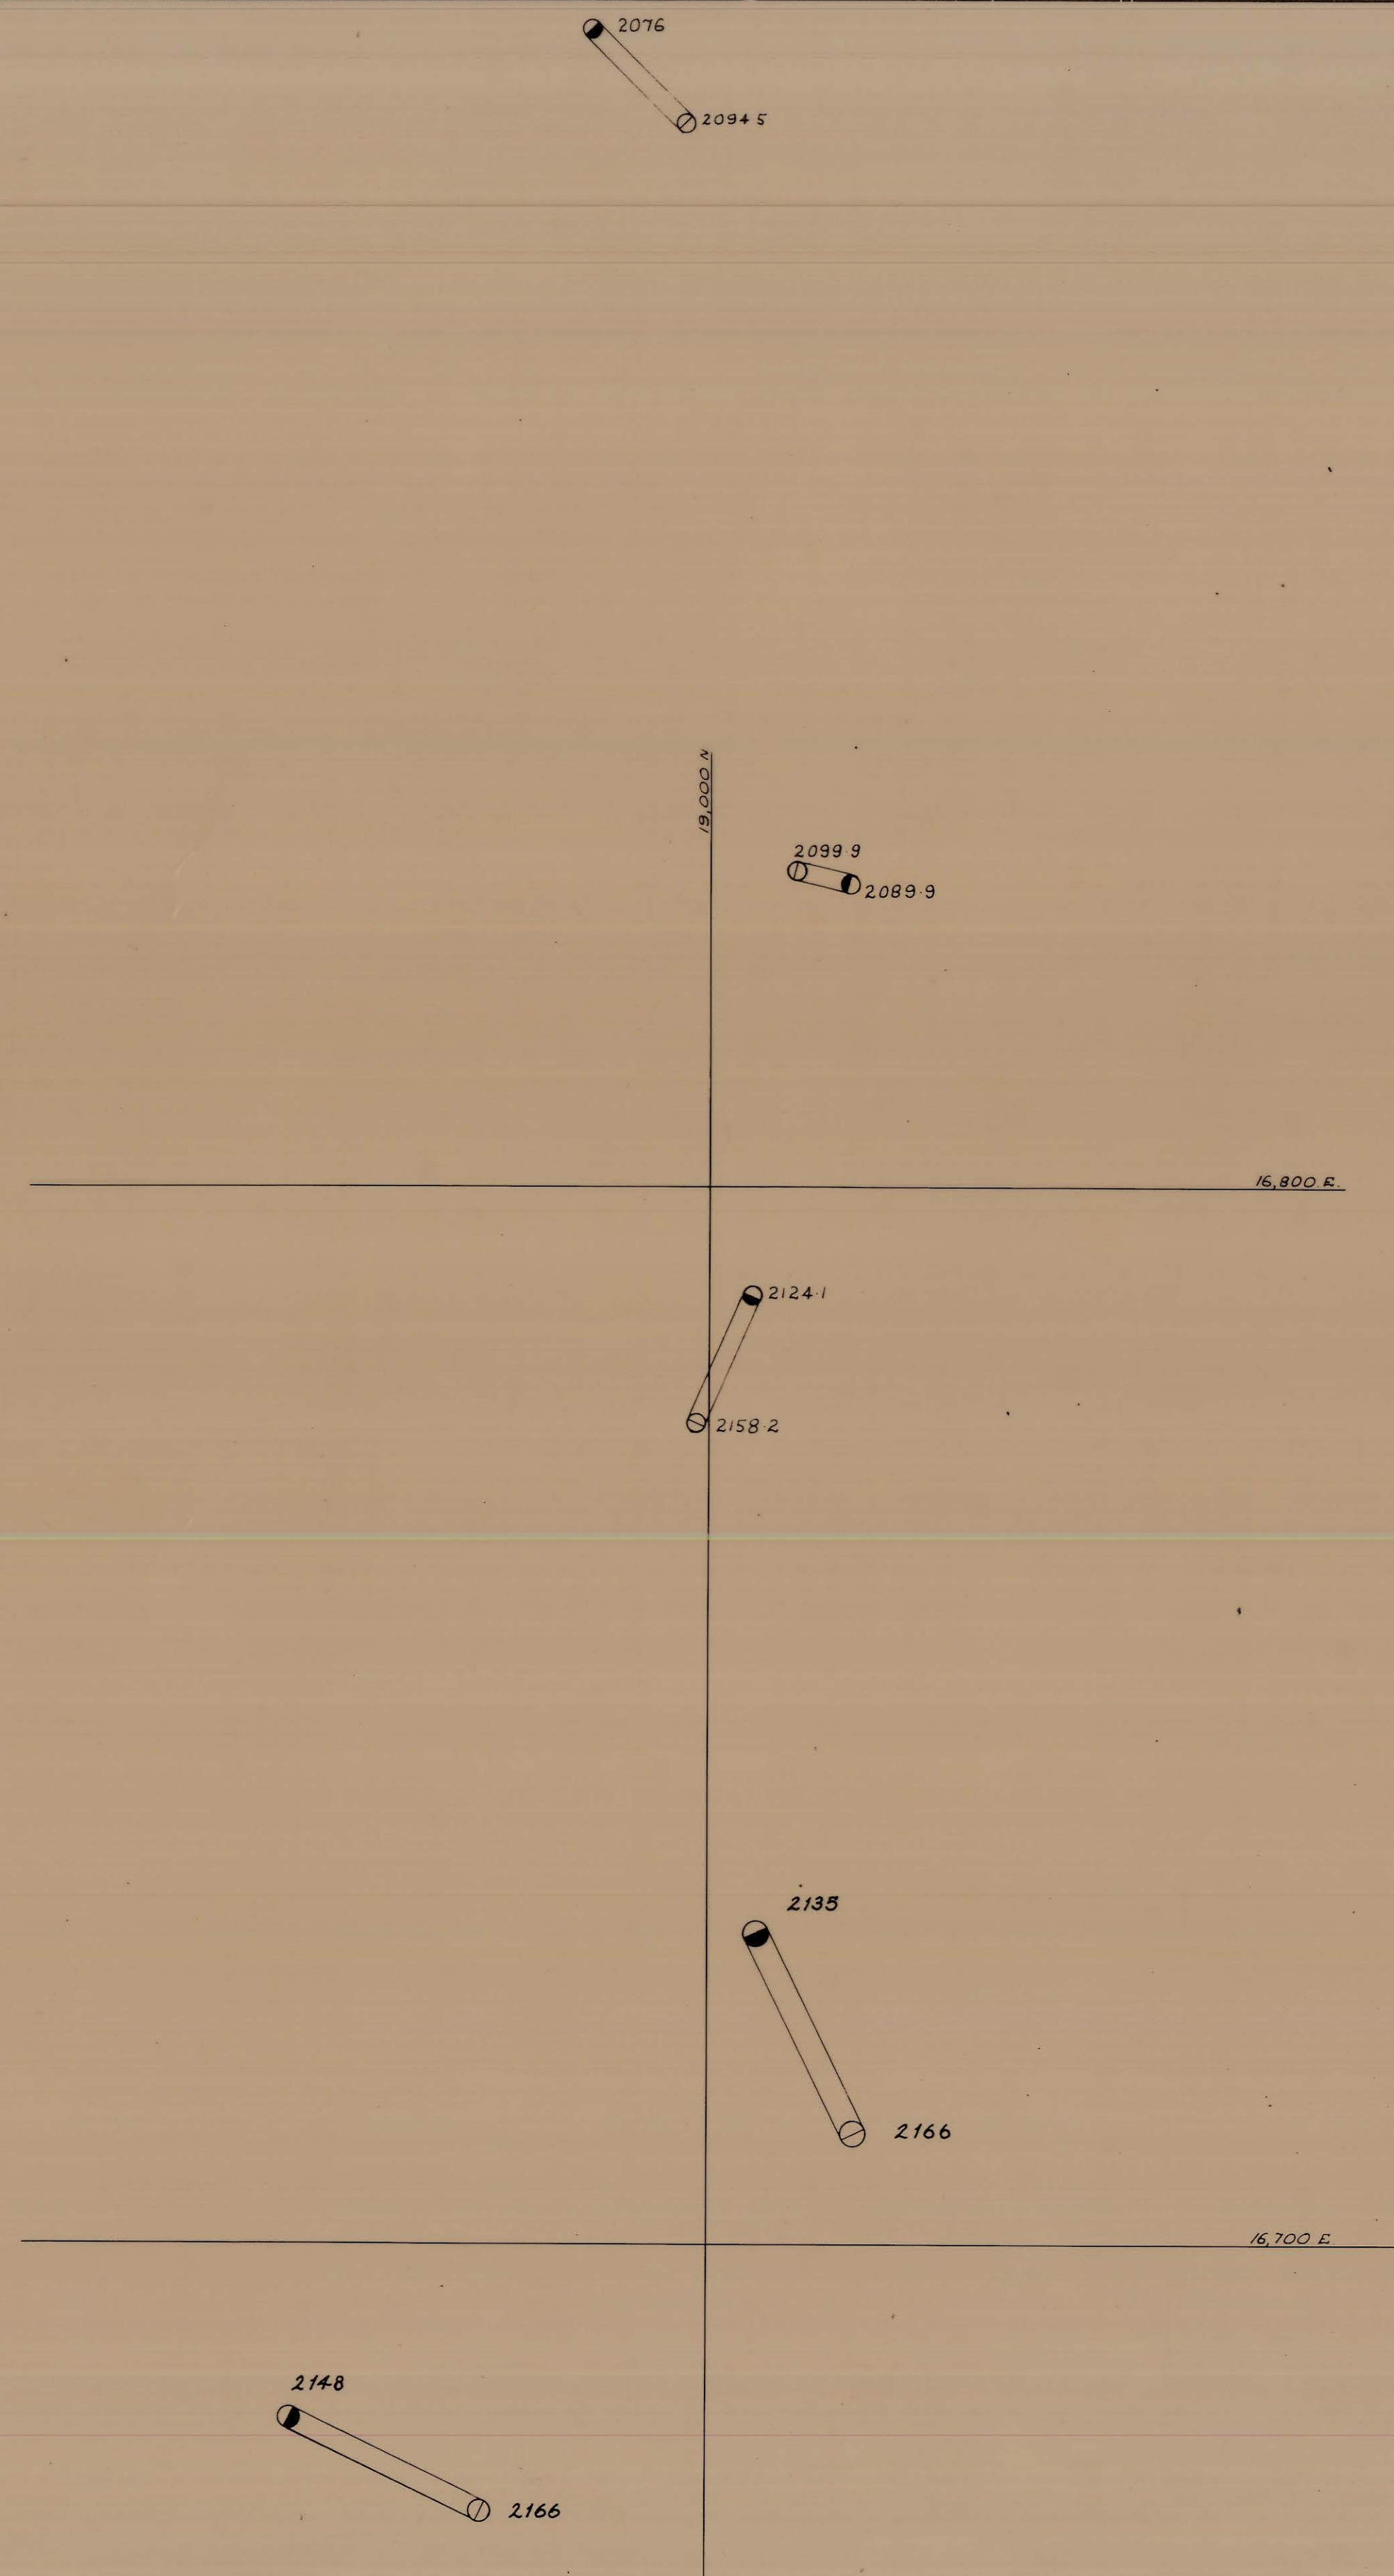

DATE	MANAGER	SURVEYOR	RENISON LIMITED SURVEY			DRAWING NO
31-12-73	<i>[Signature]</i>	<i>[Signature]</i>	DRAWN: P.W.K. DATE: 8-3-73 SCALE: 1:500			17:001
31-12-74	<i>[Signature]</i>	<i>[Signature]</i>				
31-12-75	<i>[Signature]</i>	<i>[Signature]</i>	UPPER DREADNOUGHT STOPE RISES			77-054
31-12-76	<i>[Signature]</i>	<i>[Signature]</i>				