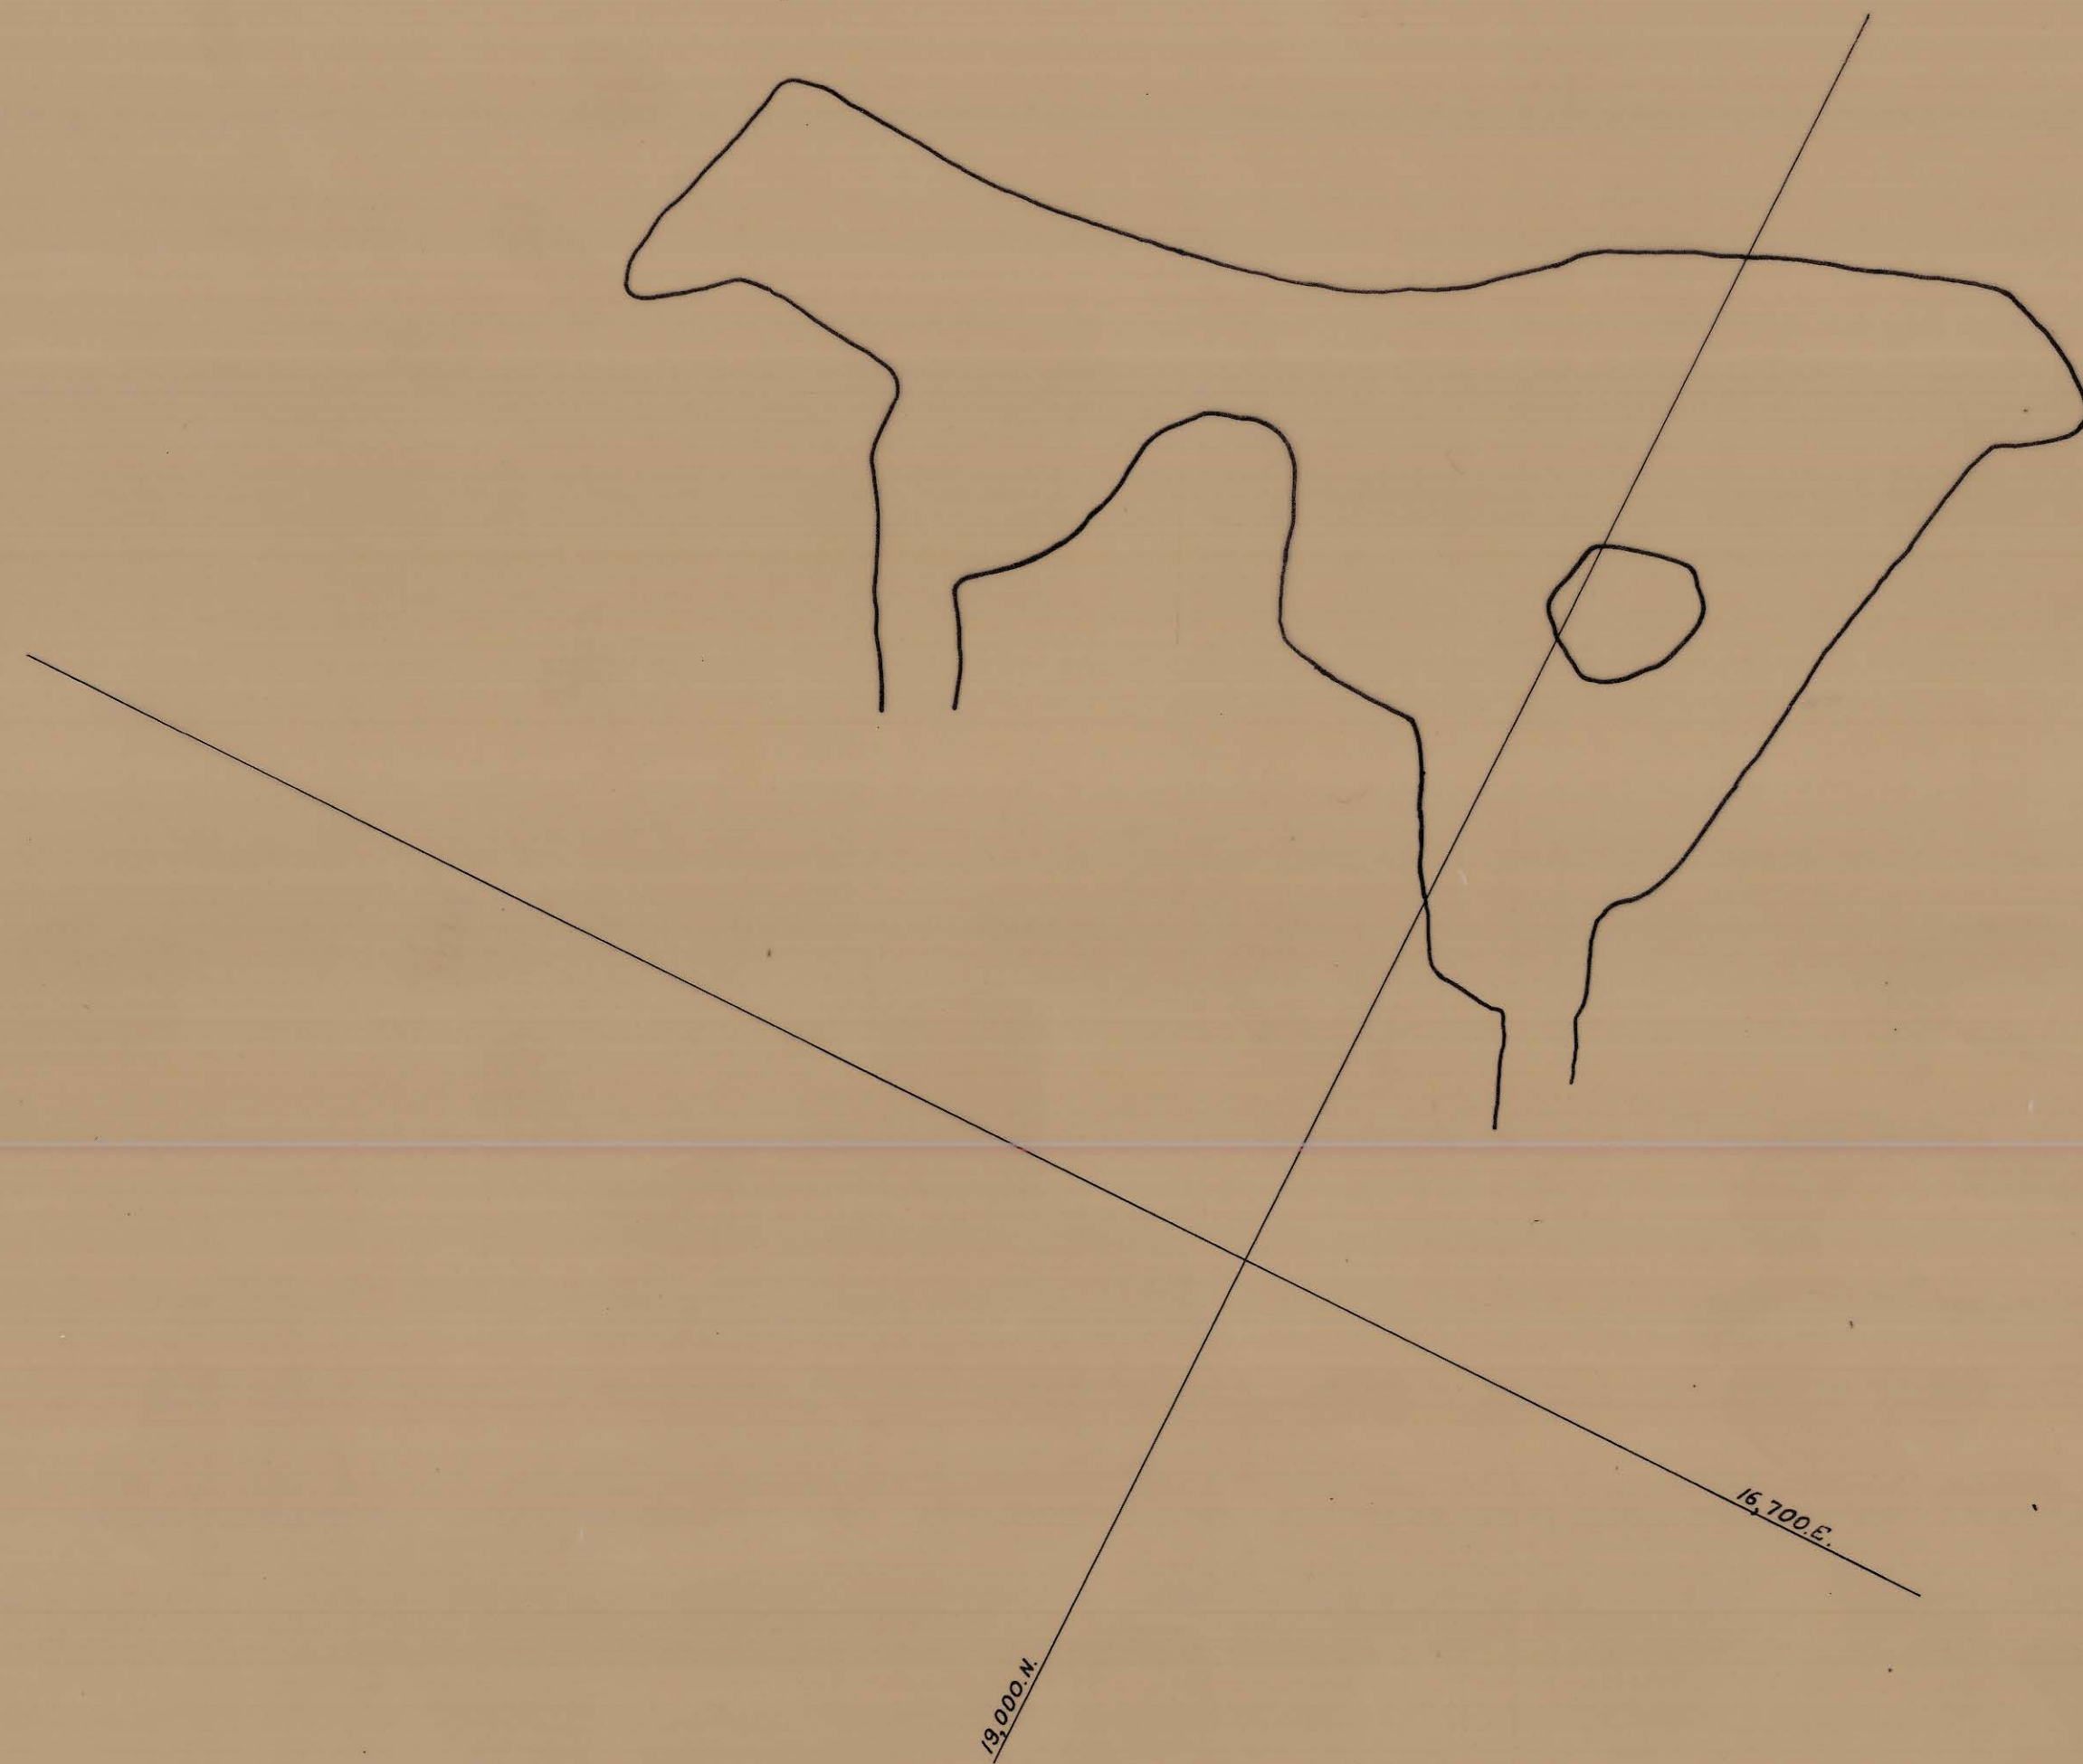


DATE	MANAGER	SURVEYOR	RENISON LIMITED SURVEY		DRAWING N°
31-12-73	<i>[Signature]</i>	<i>[Signature]</i>			
31-12-74	<i>[Signature]</i>	<i>[Signature]</i>			
31-12-75	<i>[Signature]</i>	<i>[Signature]</i>			
31-12-76	<i>[Signature]</i>	<i>[Signature]</i>			
31-12-77	<i>[Signature]</i>	<i>[Signature]</i>			
			DRAWN : P.W.K. DATE : 23-2-73 SCALE : 1:500		
			UPPER DREADNOUGHT STOPE LEVEL : 2133.00		
					17:001 77-052