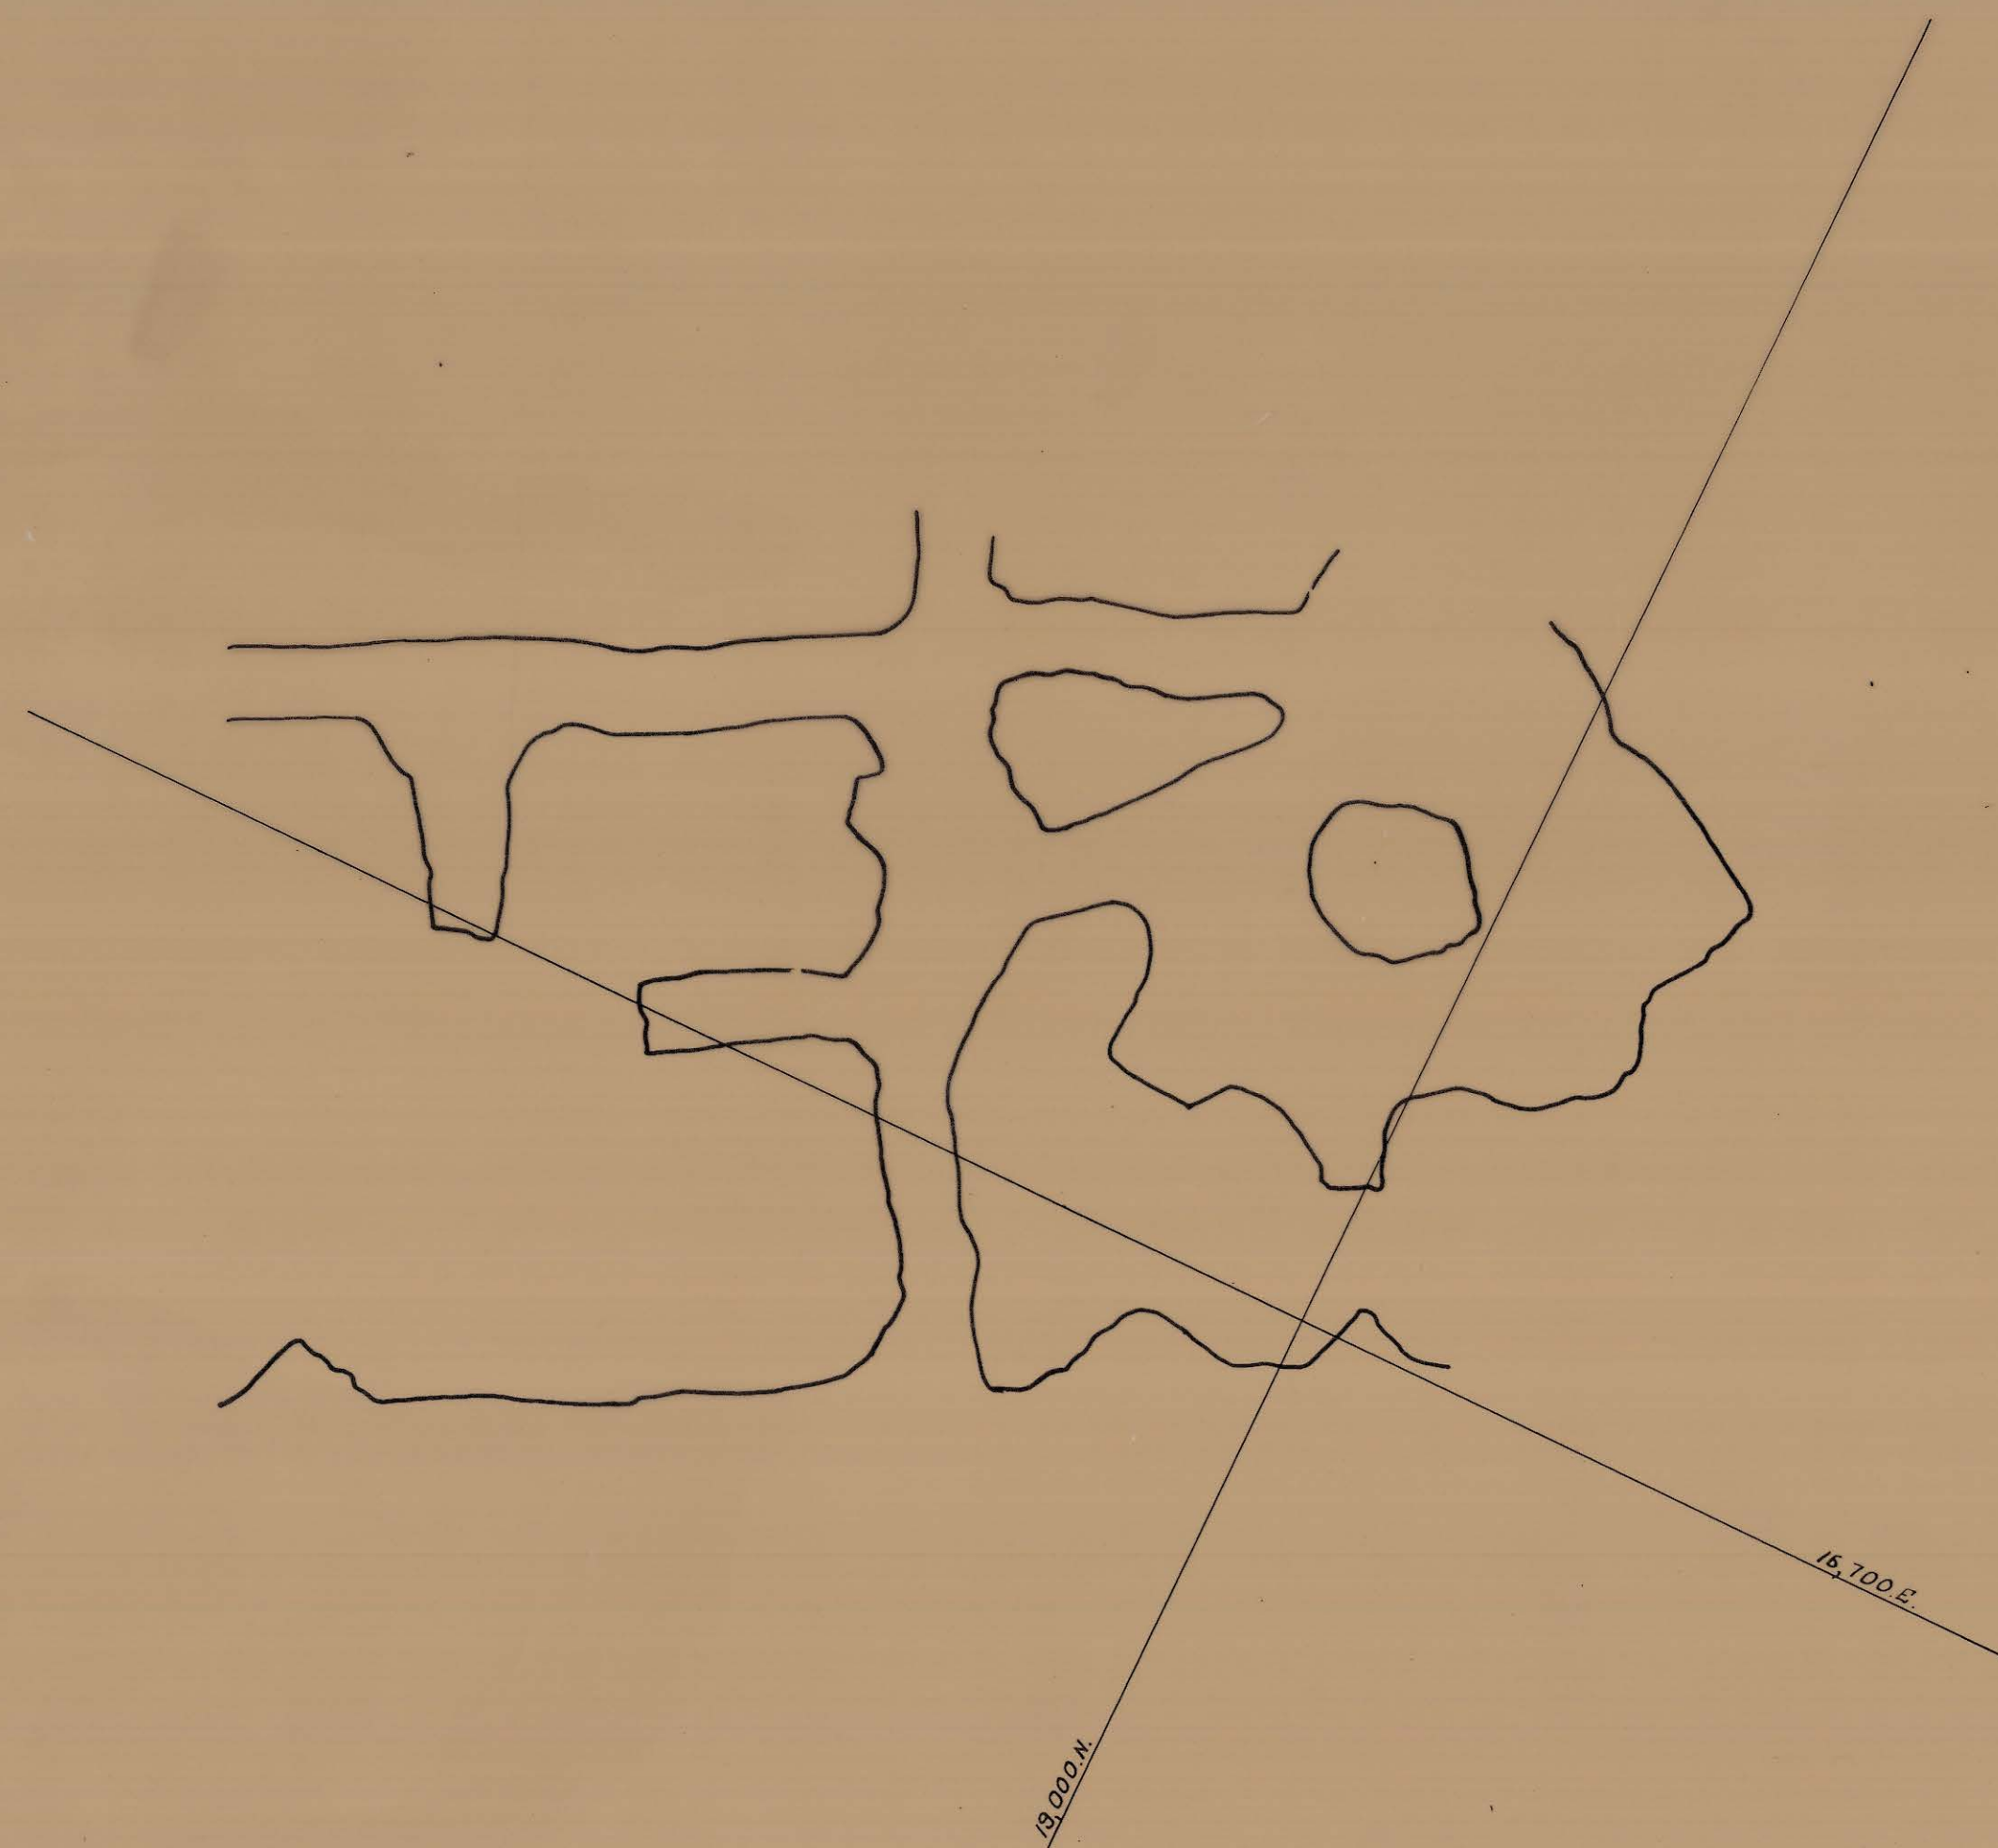


DATE	MANAGER	SURVEYOR	RENISON LIMITED SURVEY			DRAWING N°
31-12-73	<i>[Signature]</i>	<i>[Signature]</i>	DRAWN : P.W.K.	DATE : 23-2-73	SCALE : 1 : 500	17:001
31-12-74	<i>[Signature]</i>	<i>[Signature]</i>				
31-12-75	<i>[Signature]</i>	<i>[Signature]</i>				
31-12-76	<i>[Signature]</i>	<i>[Signature]</i>				
			UPPER DREADNOUGHT STOPE LEVEL : 2140.00			77-050