


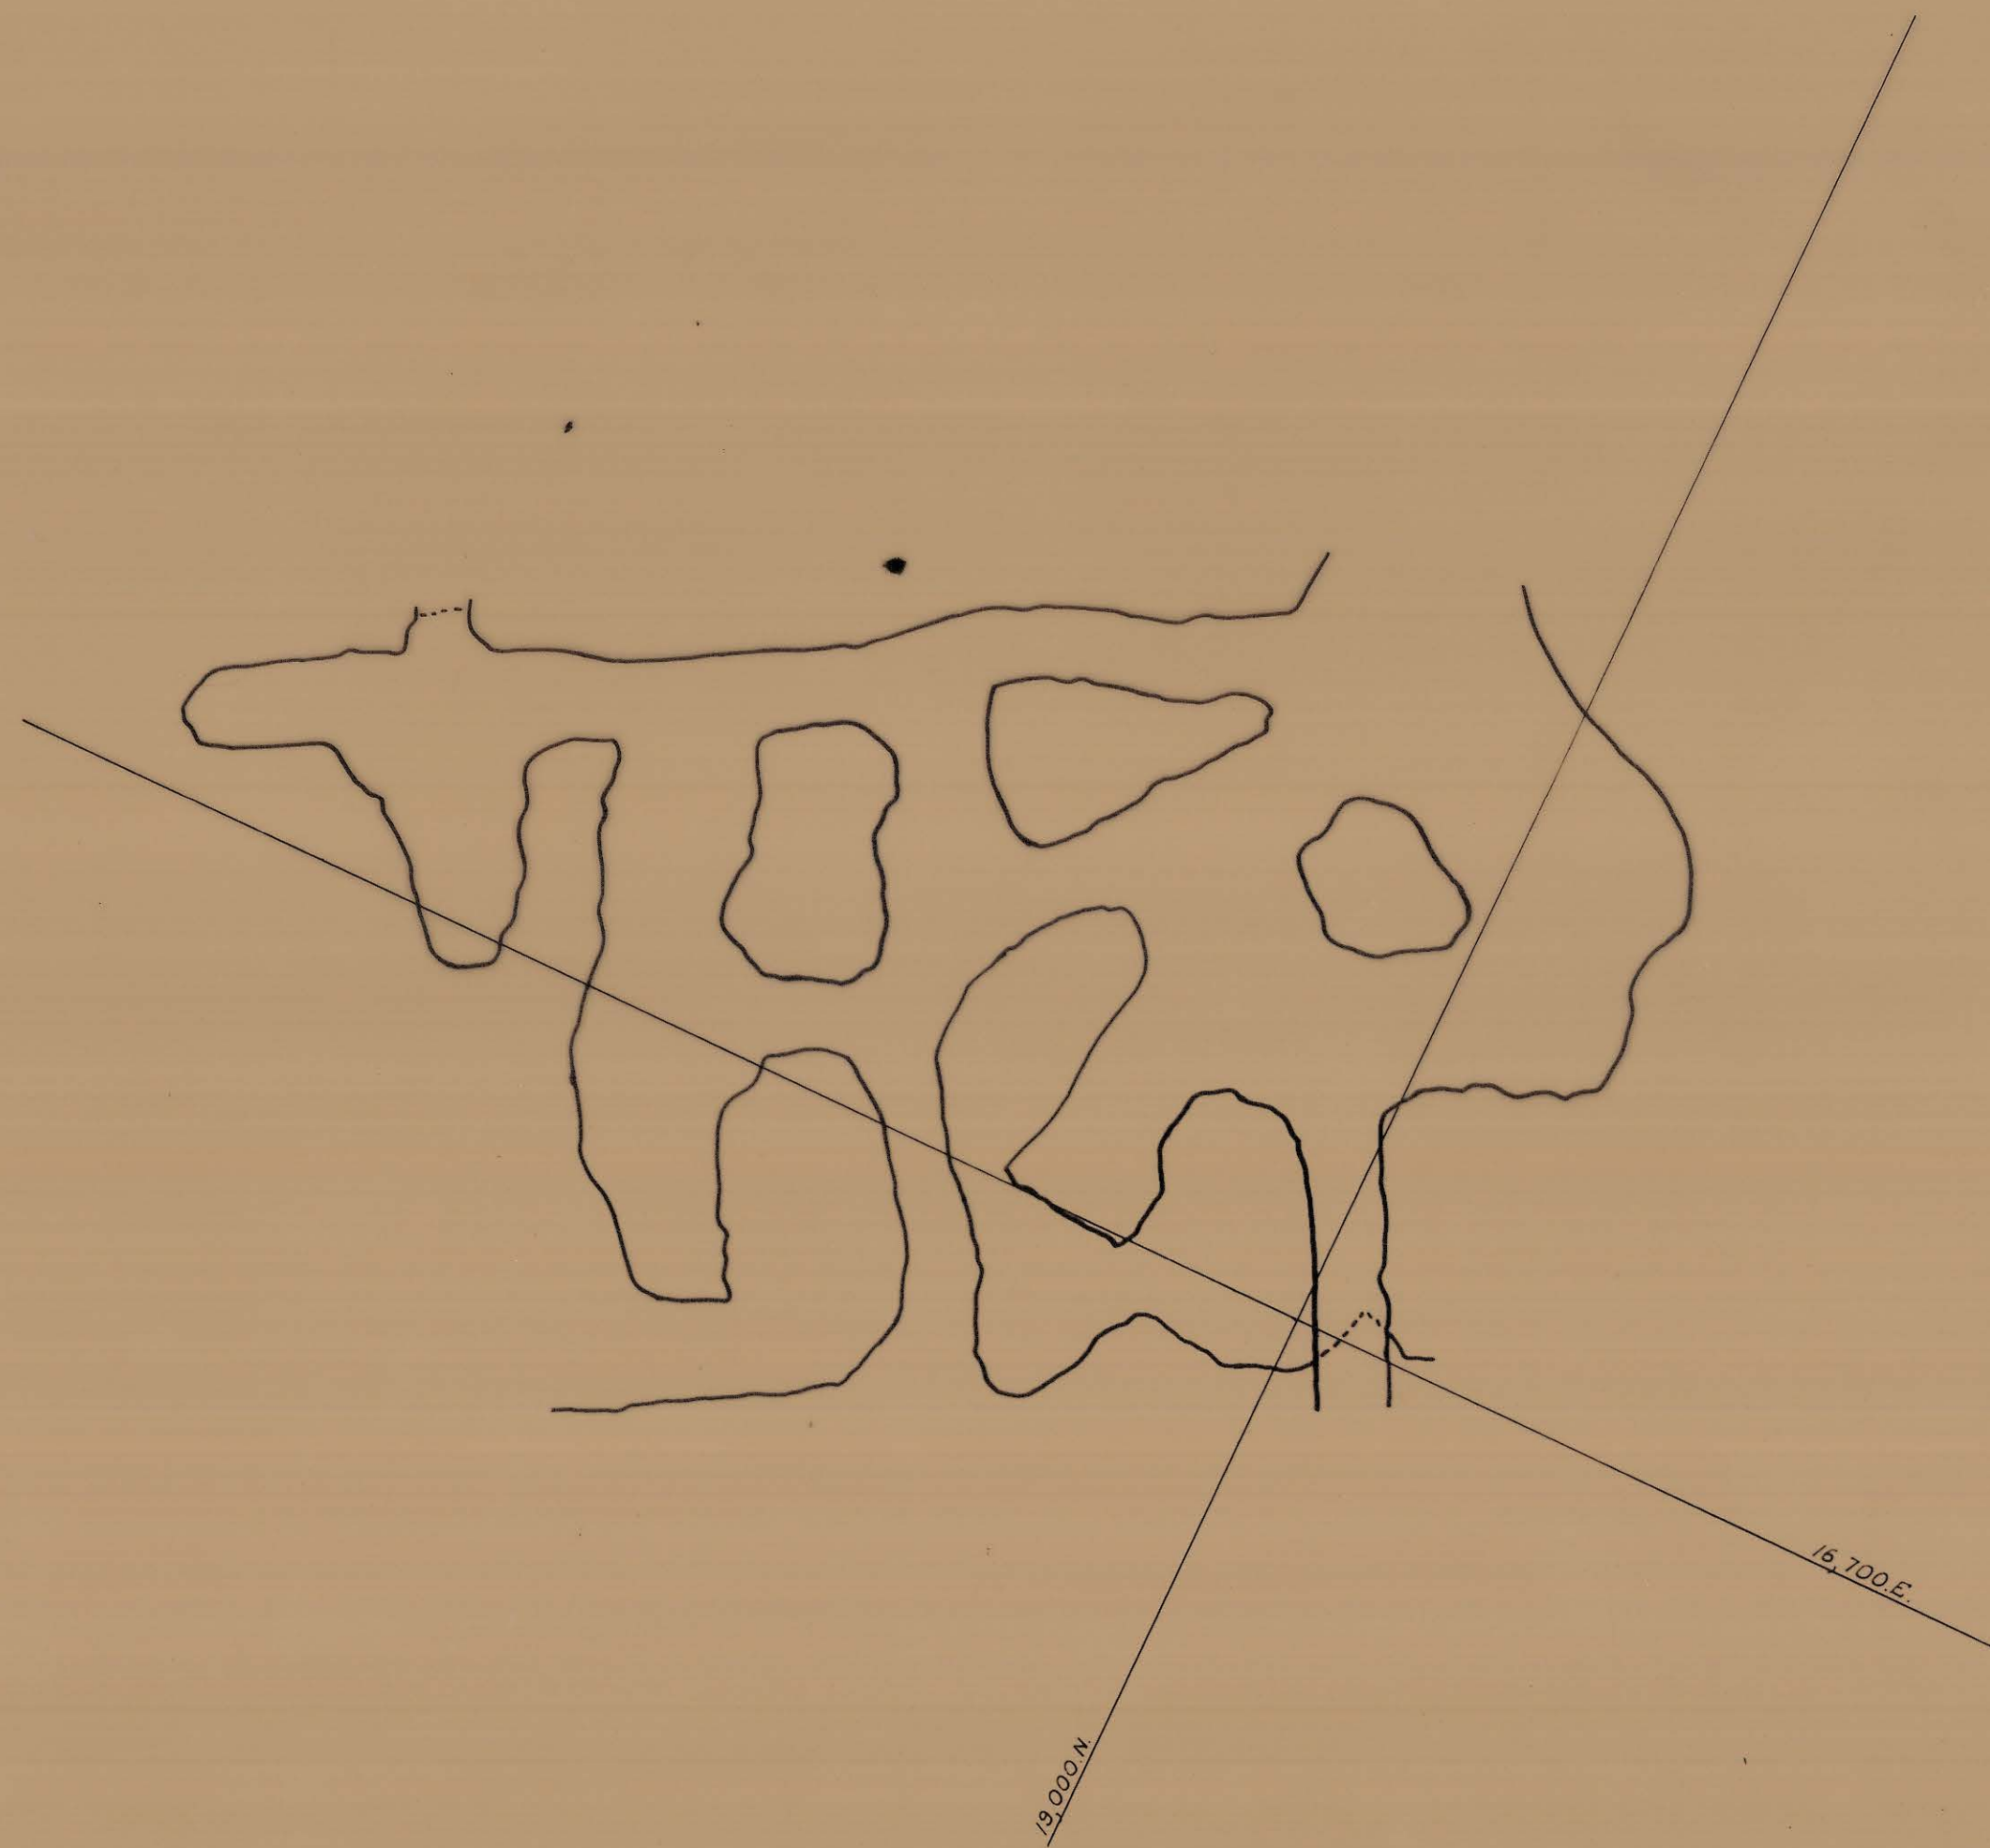

5 cm

DATE	MANAGER	SURVEYOR	RENISON LIMITED SURVEY			DRAWING N°
31-12-73	<i>[Signature]</i>	<i>[Signature]</i>	DRAWN: P.W.K.	DATE: 23-2-73	SCALE: 1:500	17:001 77-049
31-12-74	<i>[Signature]</i>	<i>[Signature]</i>				
31-12-75	<i>[Signature]</i>	<i>[Signature]</i>				
31-12-76	<i>[Signature]</i>	<i>[Signature]</i>				
			UPPER DREADNOUGHT STOPE LEVEL: 2142.00			