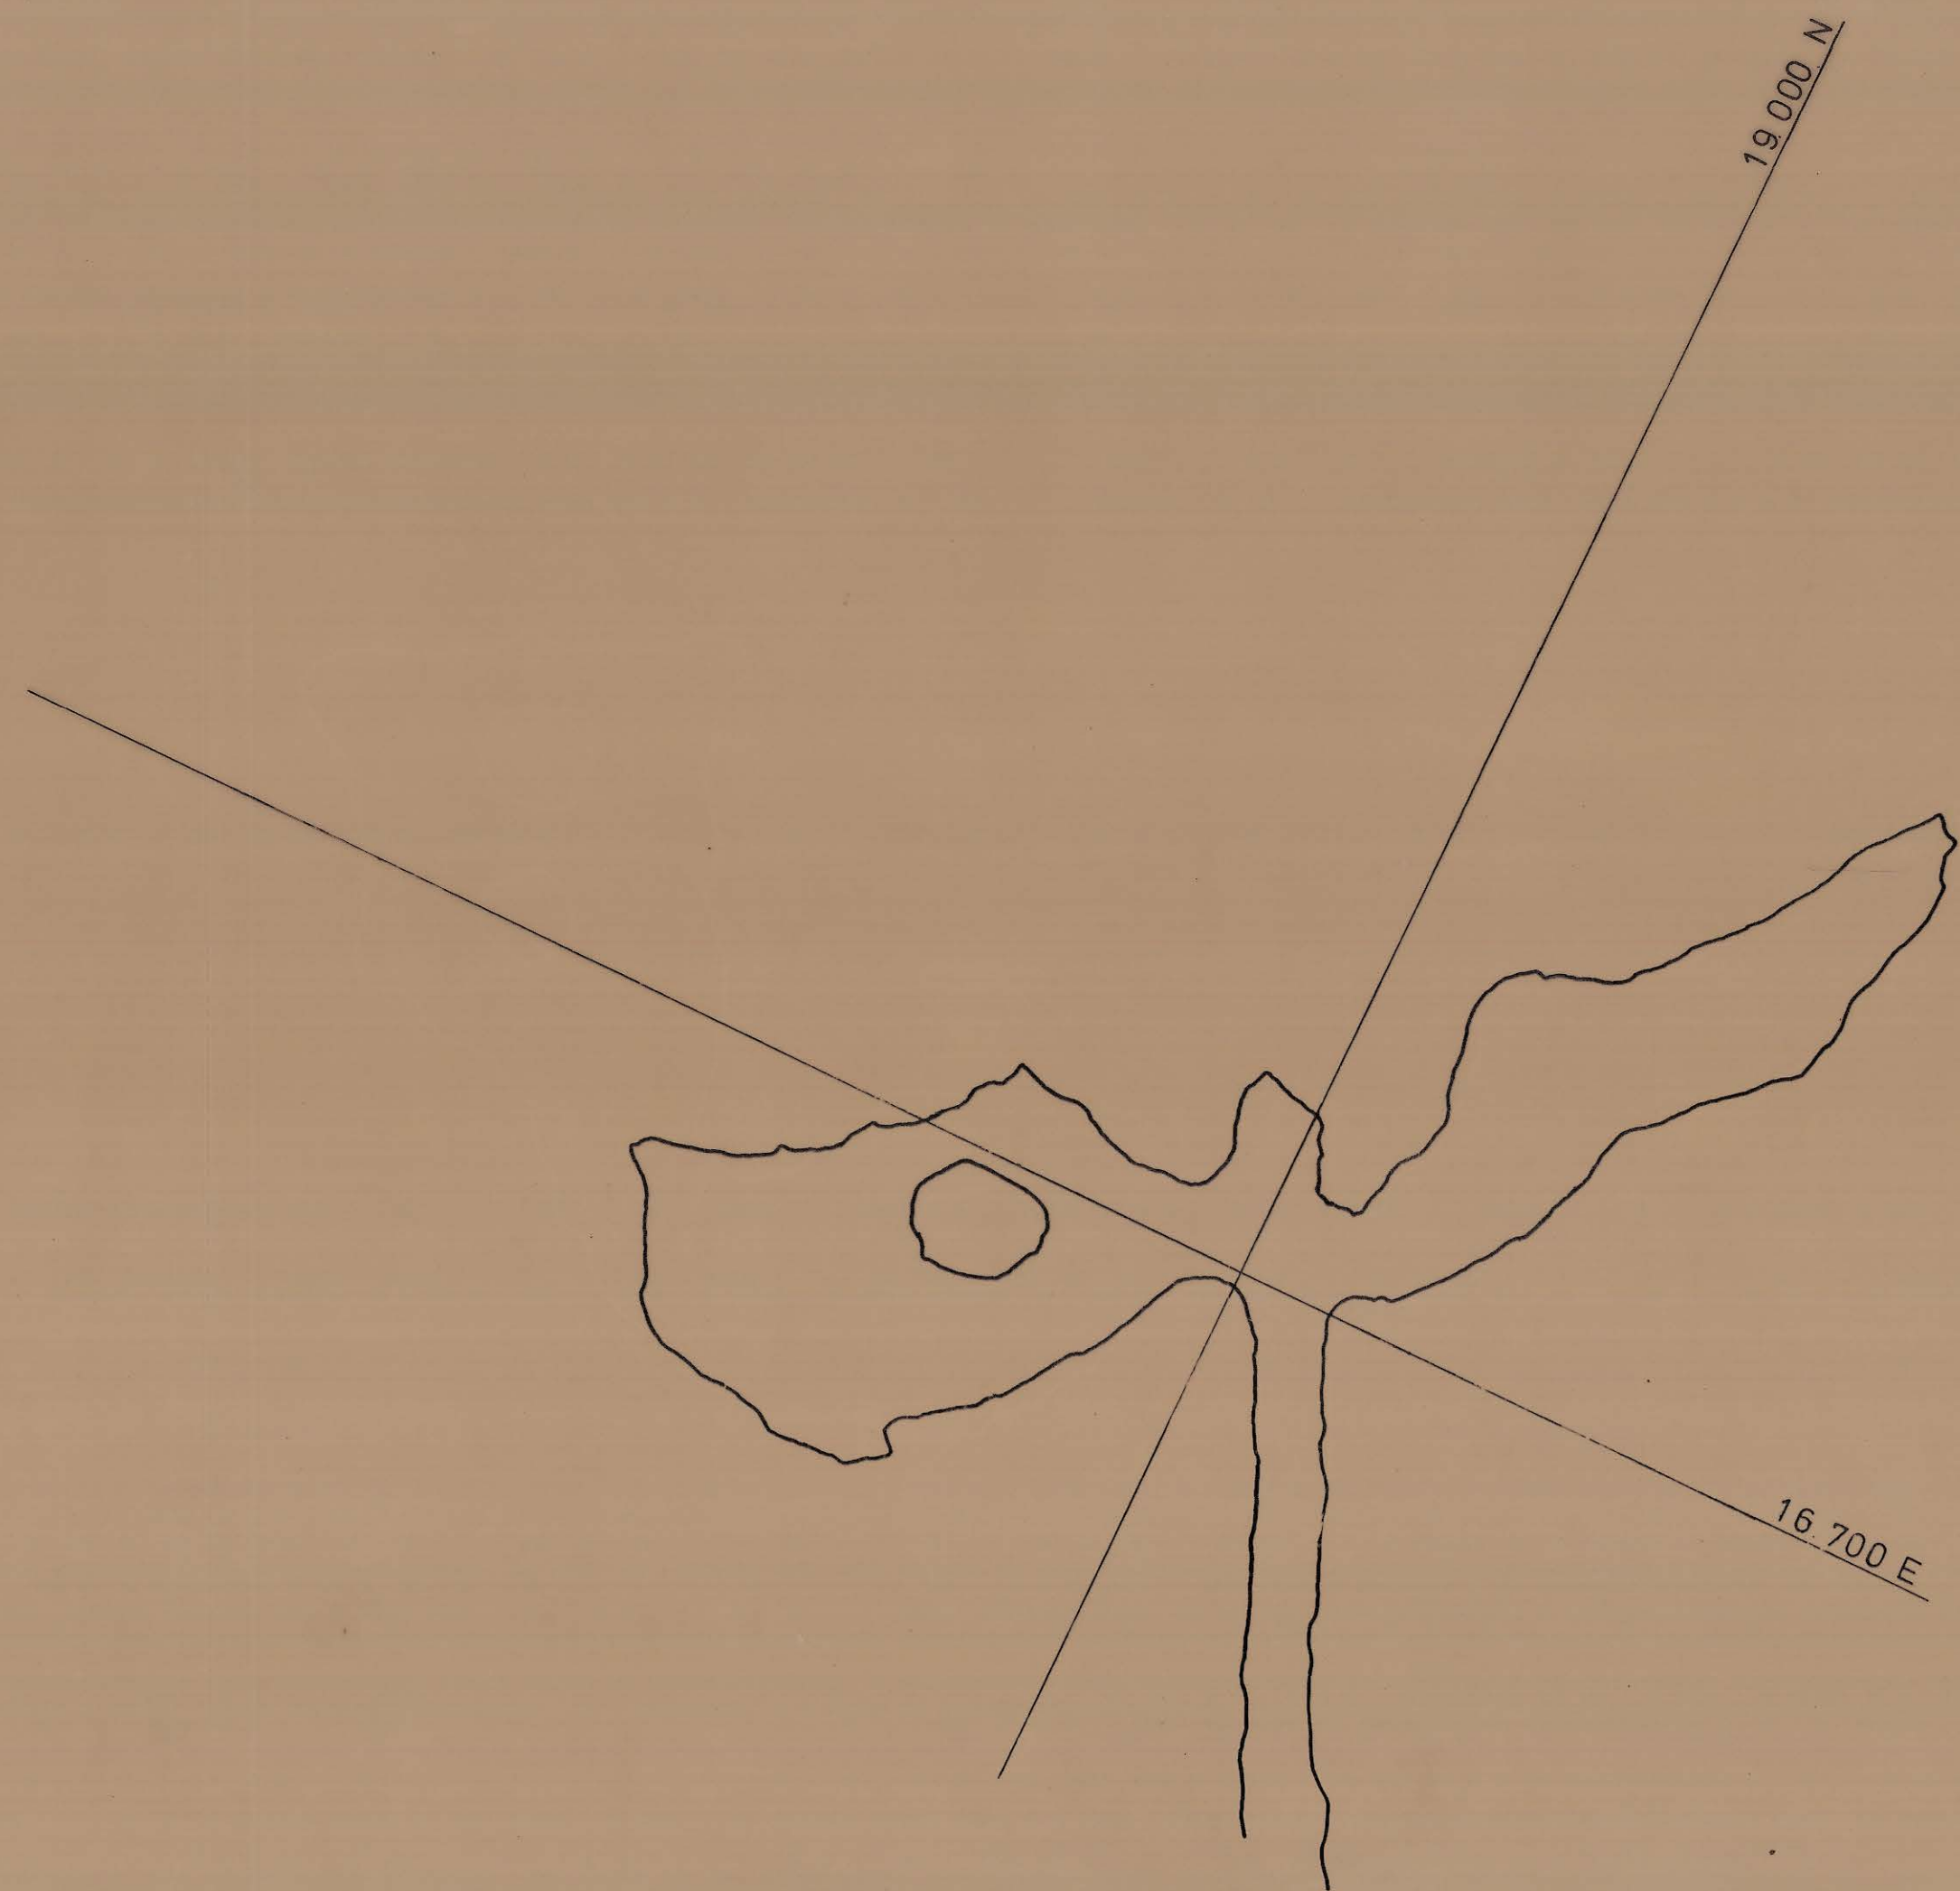


DATE		MANAGER	SURVEYOR	RENISON LIMITED			DRAWING No.
31-12-74		<i>[Signature]</i>	<i>[Signature]</i>	SURVEY			
31-12-75		<i>[Signature]</i>	<i>[Signature]</i>	DRAWN. A.J.M.	DATE. APRIL 74	SCALE. 1:500	
31-12-76		<i>[Signature]</i>	<i>[Signature]</i>	UPPER DREADNOUGHT STOPE			
				LEVEL 2152			17:001
							77-046