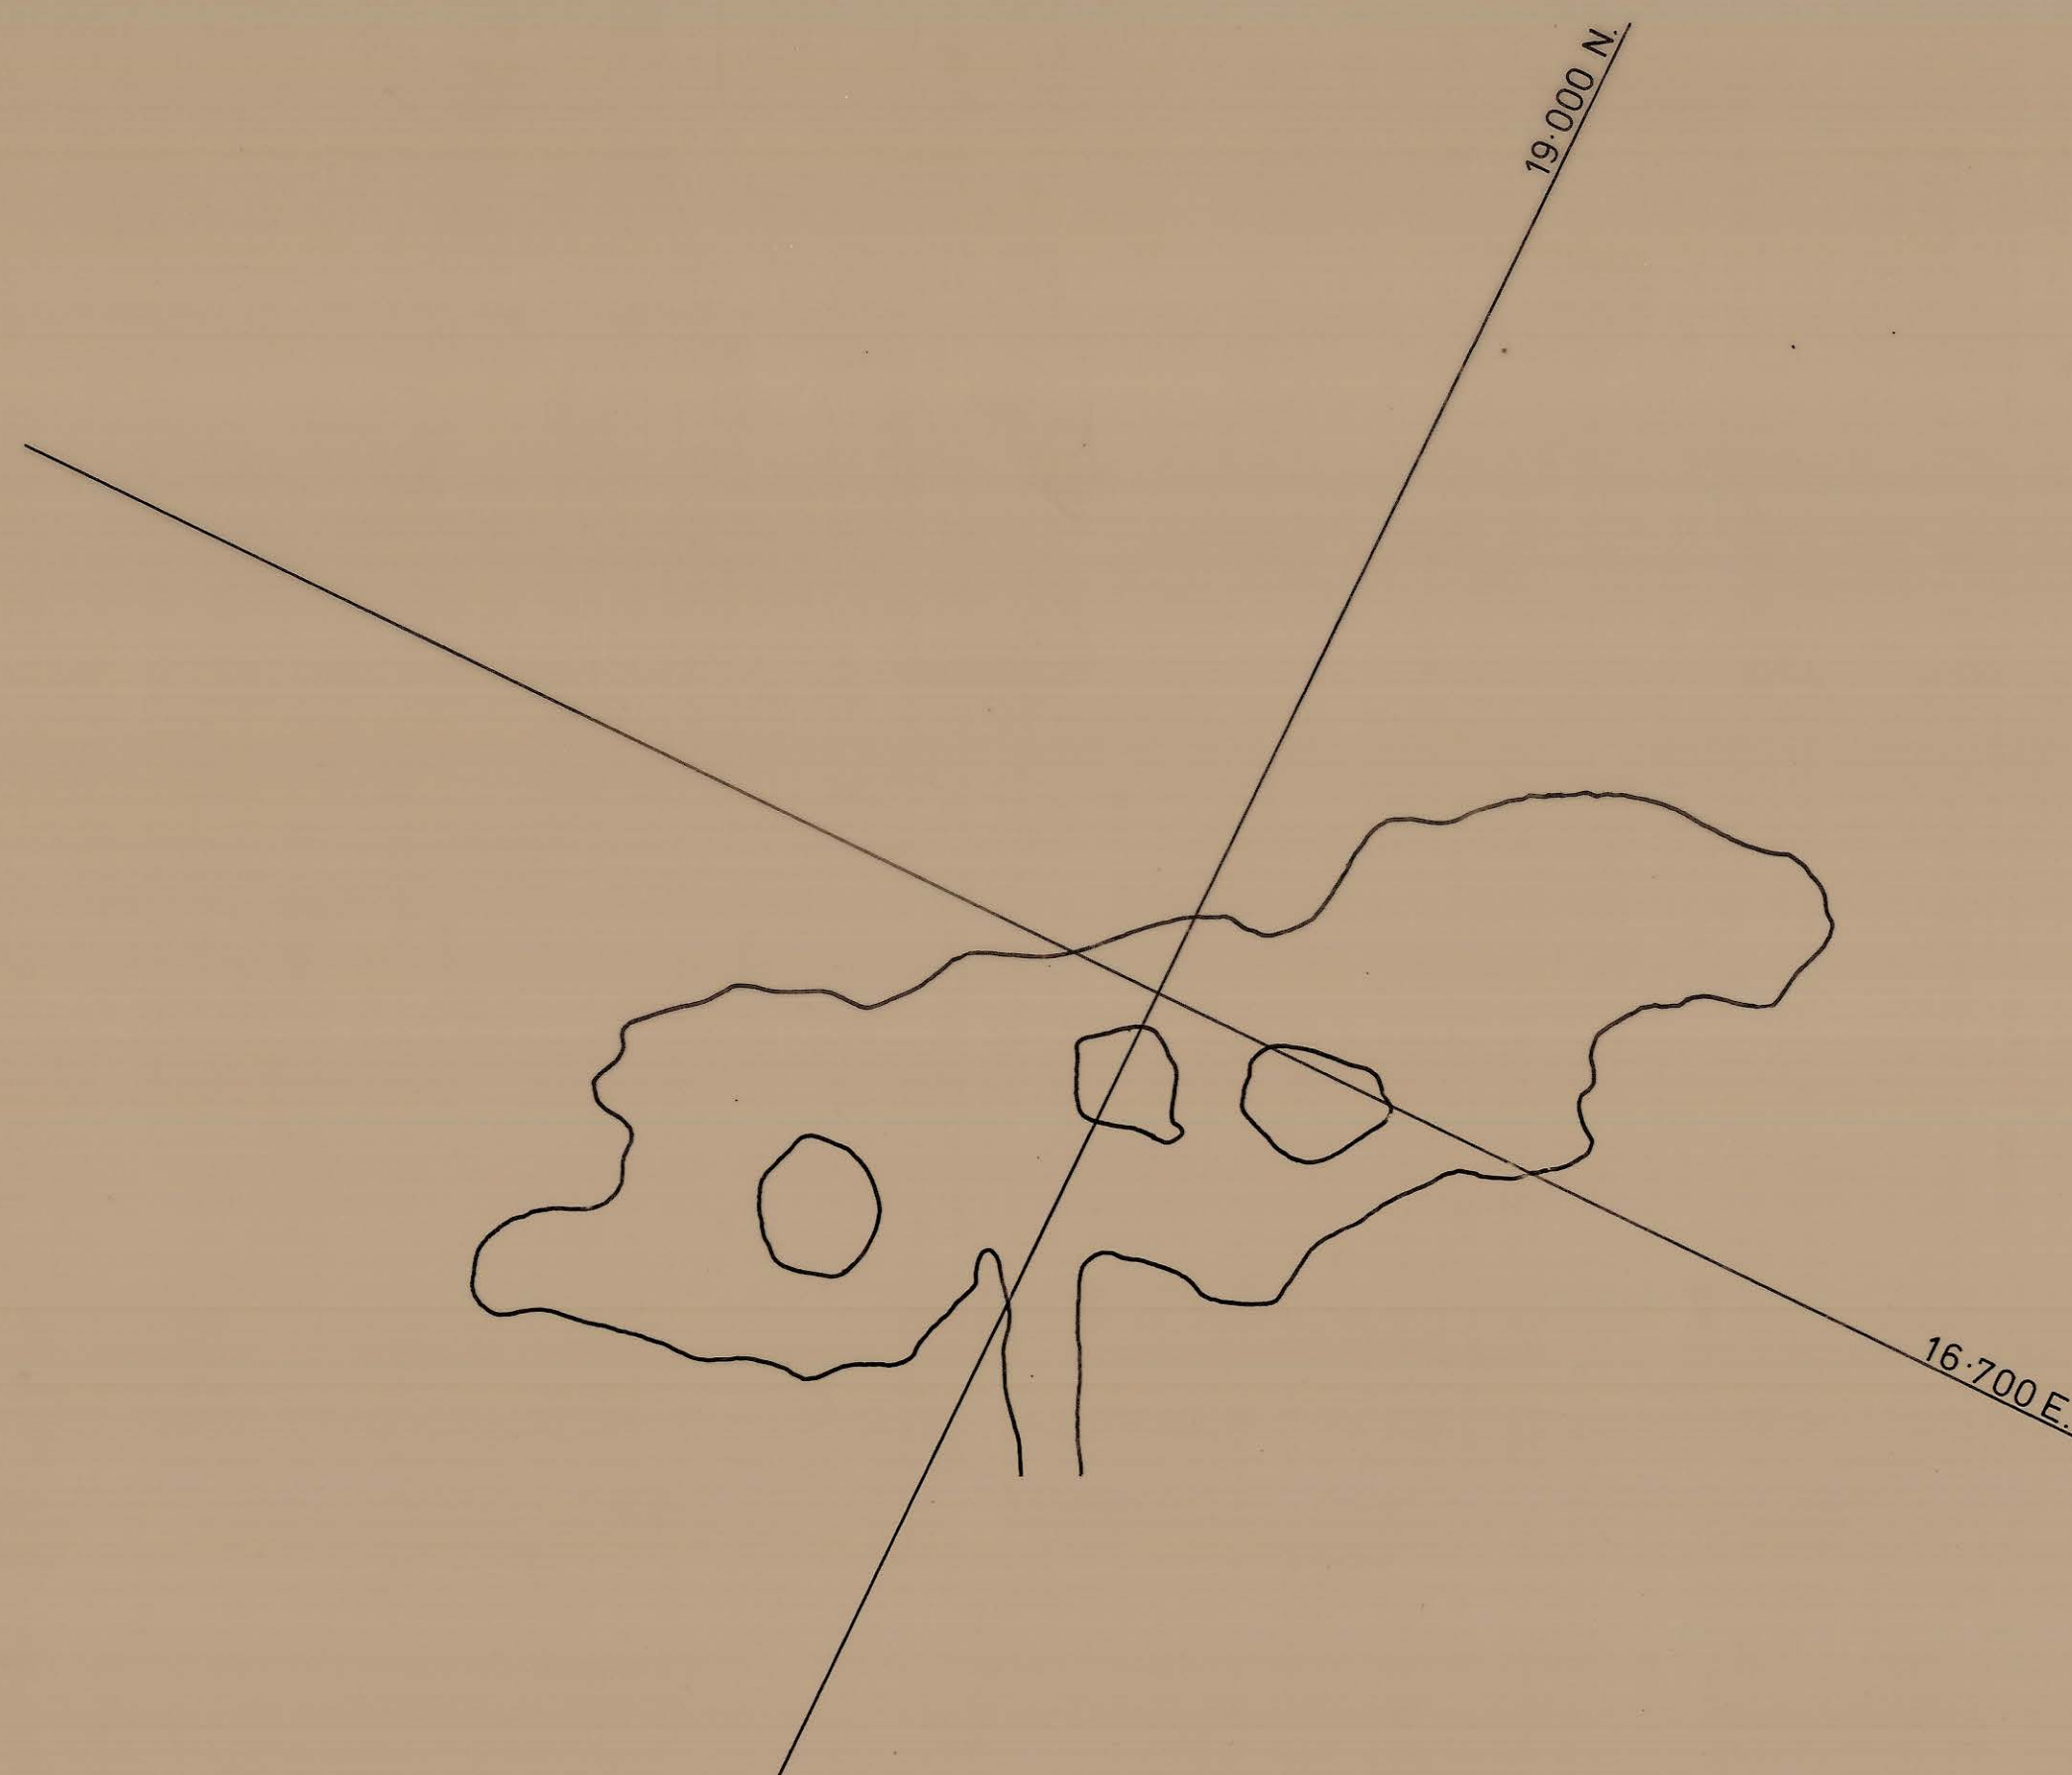


DATE			MANAGER			SURVEYOR			RENISON LIMITED SURVEY.			DRAWING No.	
31-12-75												17-001. 77-044	
31-12-76									DRAWN: F.M.H.	DATE: 10-12-75	SCALE: 1:500.		
									UPPER DREADNOUGHT STOPE.				
									FILL LEVEL : 2160.				