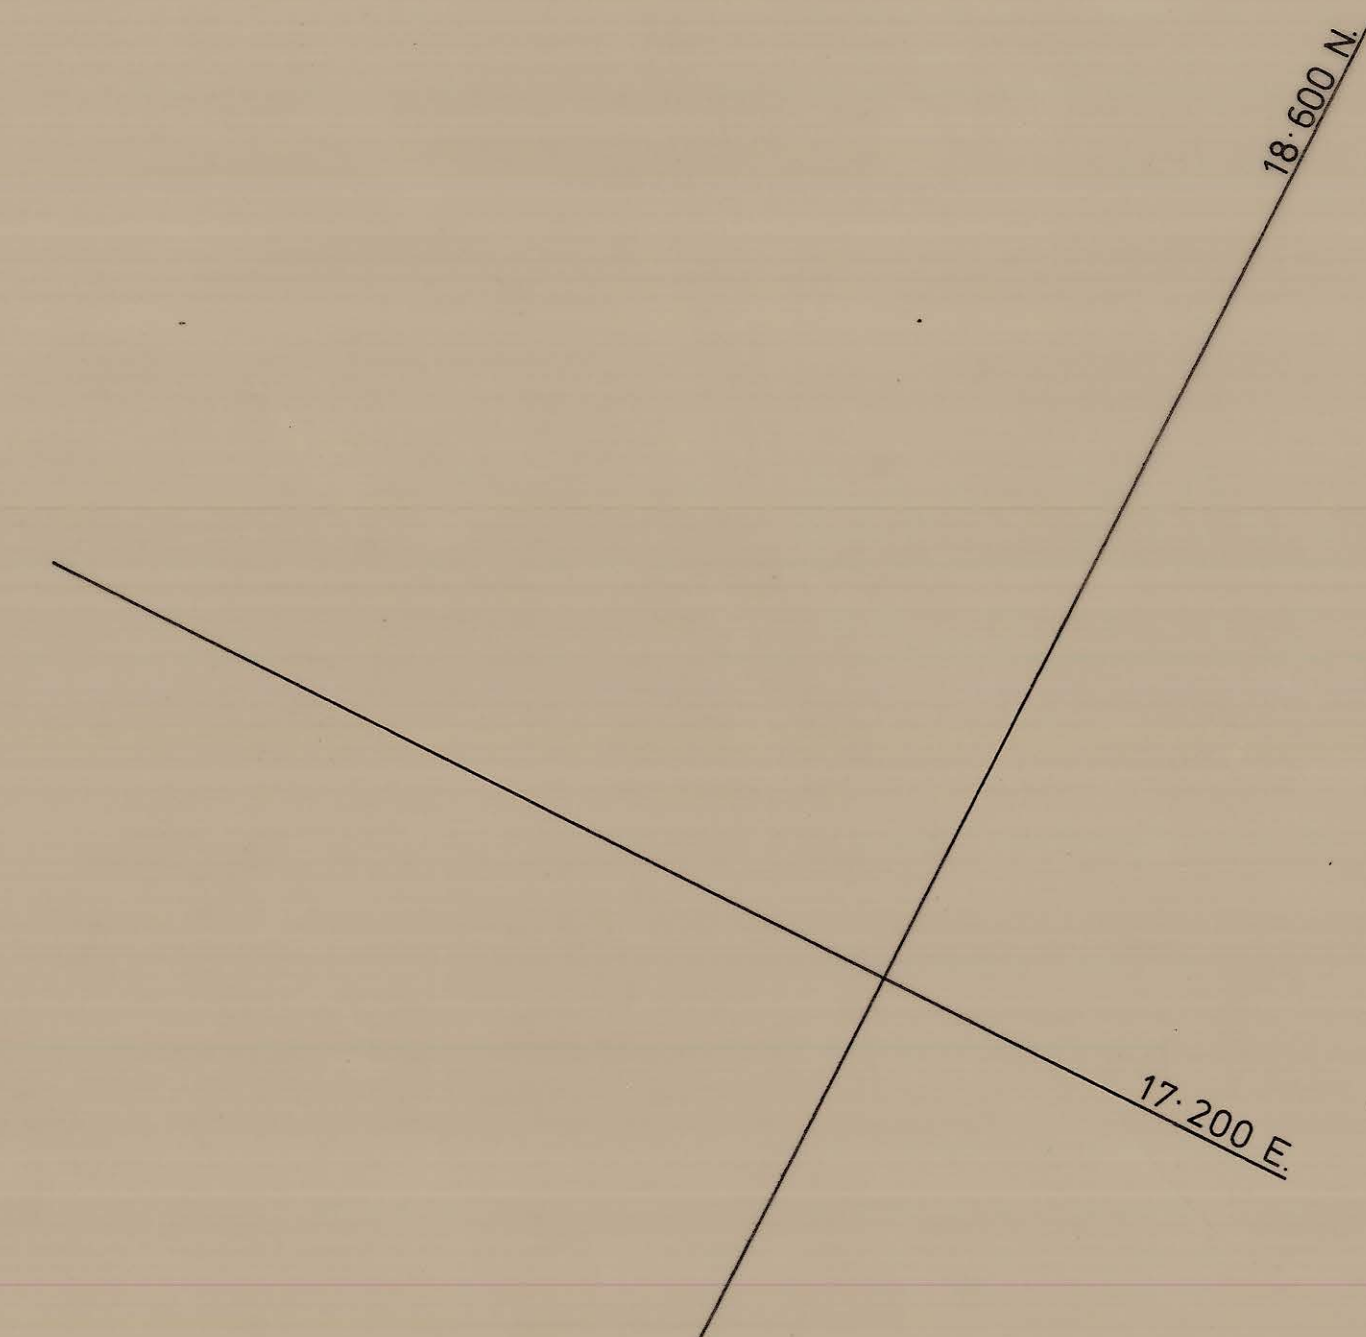
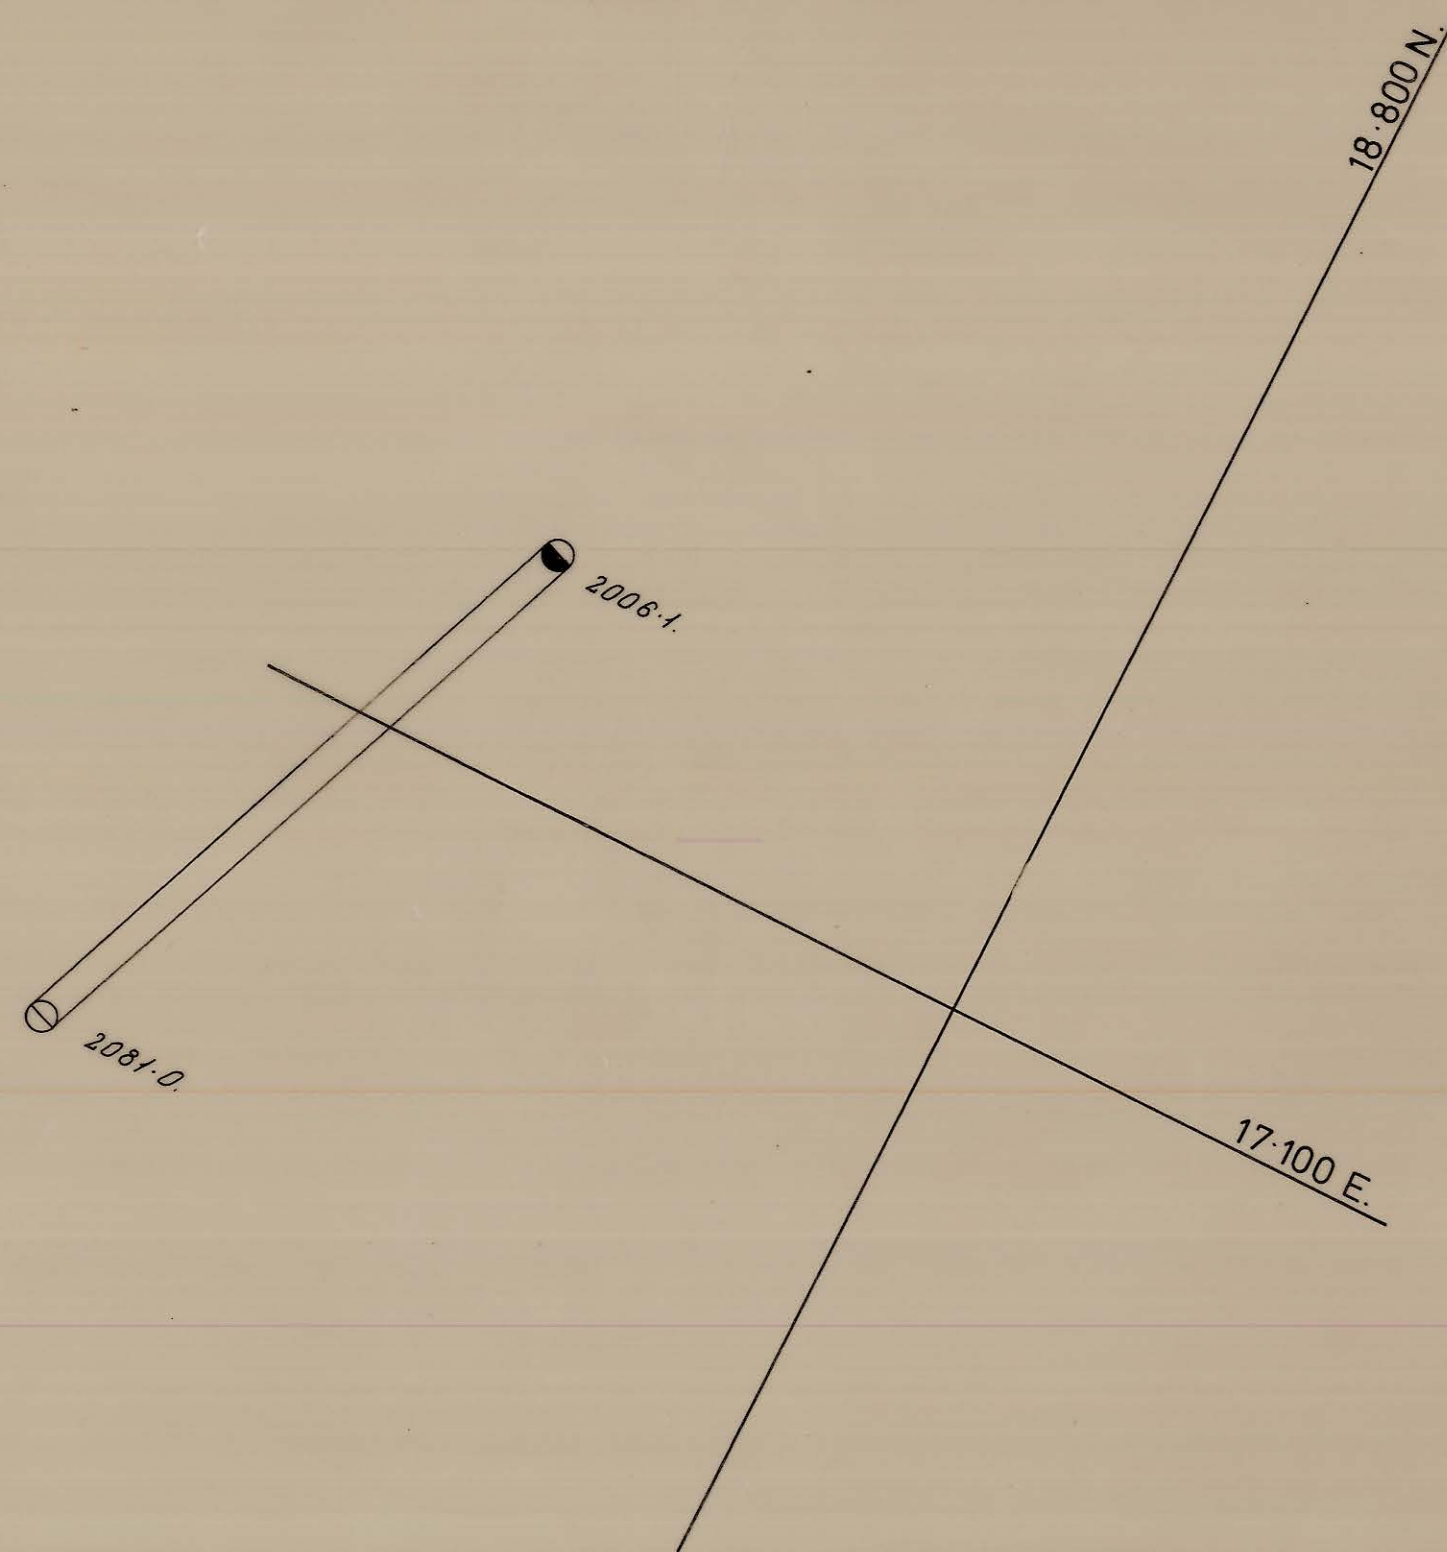


DATE	MANAGER	SURVEYOR	REINSON LIMITED SURVEY			DRAWING NO.
11-12-78	11-12-78	11-12-78	13-001			
3/1/80			77042			
			DRAWN: K.M.H.	DATE: 11-12-78	SCALE: 1:500	
			LOWER FEDERAL STOPE RISES.			

0376_594