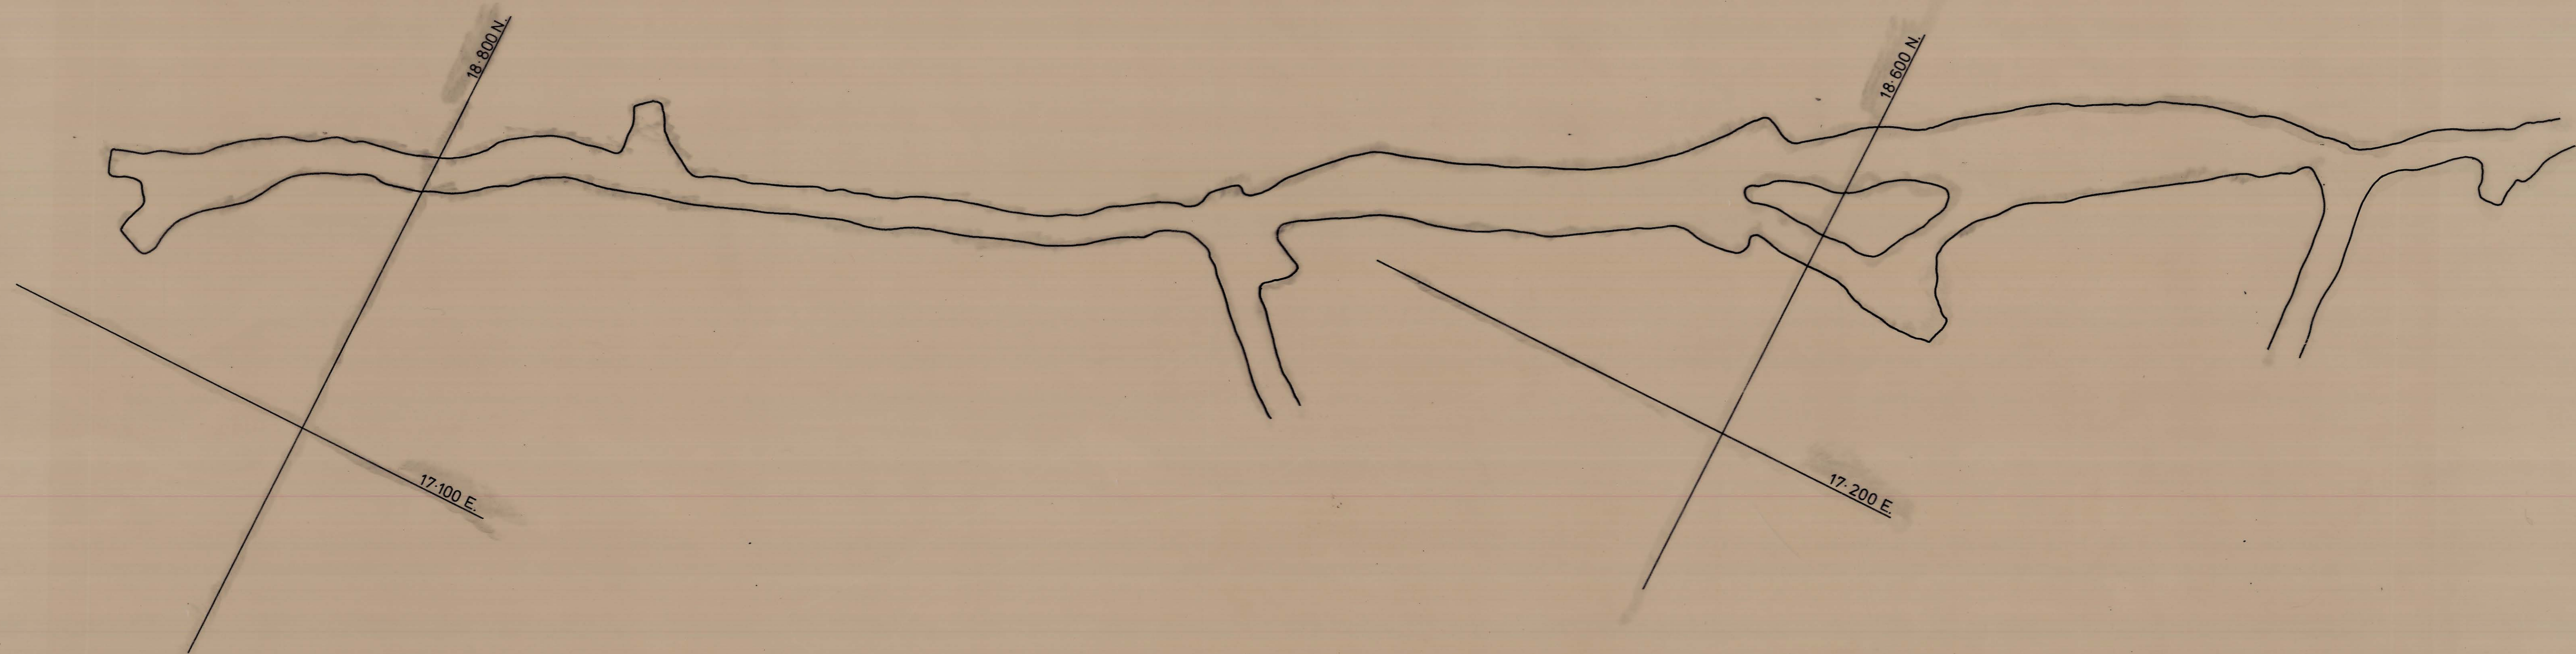


DATE: 31/12/99	MANAGER: [Signature]	SURVEYOR: [Signature]	RENISON LIMITED SURVEY	DRAWING NO.
31/12/99	31/12/99	31/12/99	DATE: DECEMBER 99 SCALE: 1:500	13:001
LOWER FEDERAL STOPE LEVEL: 1999				77041