


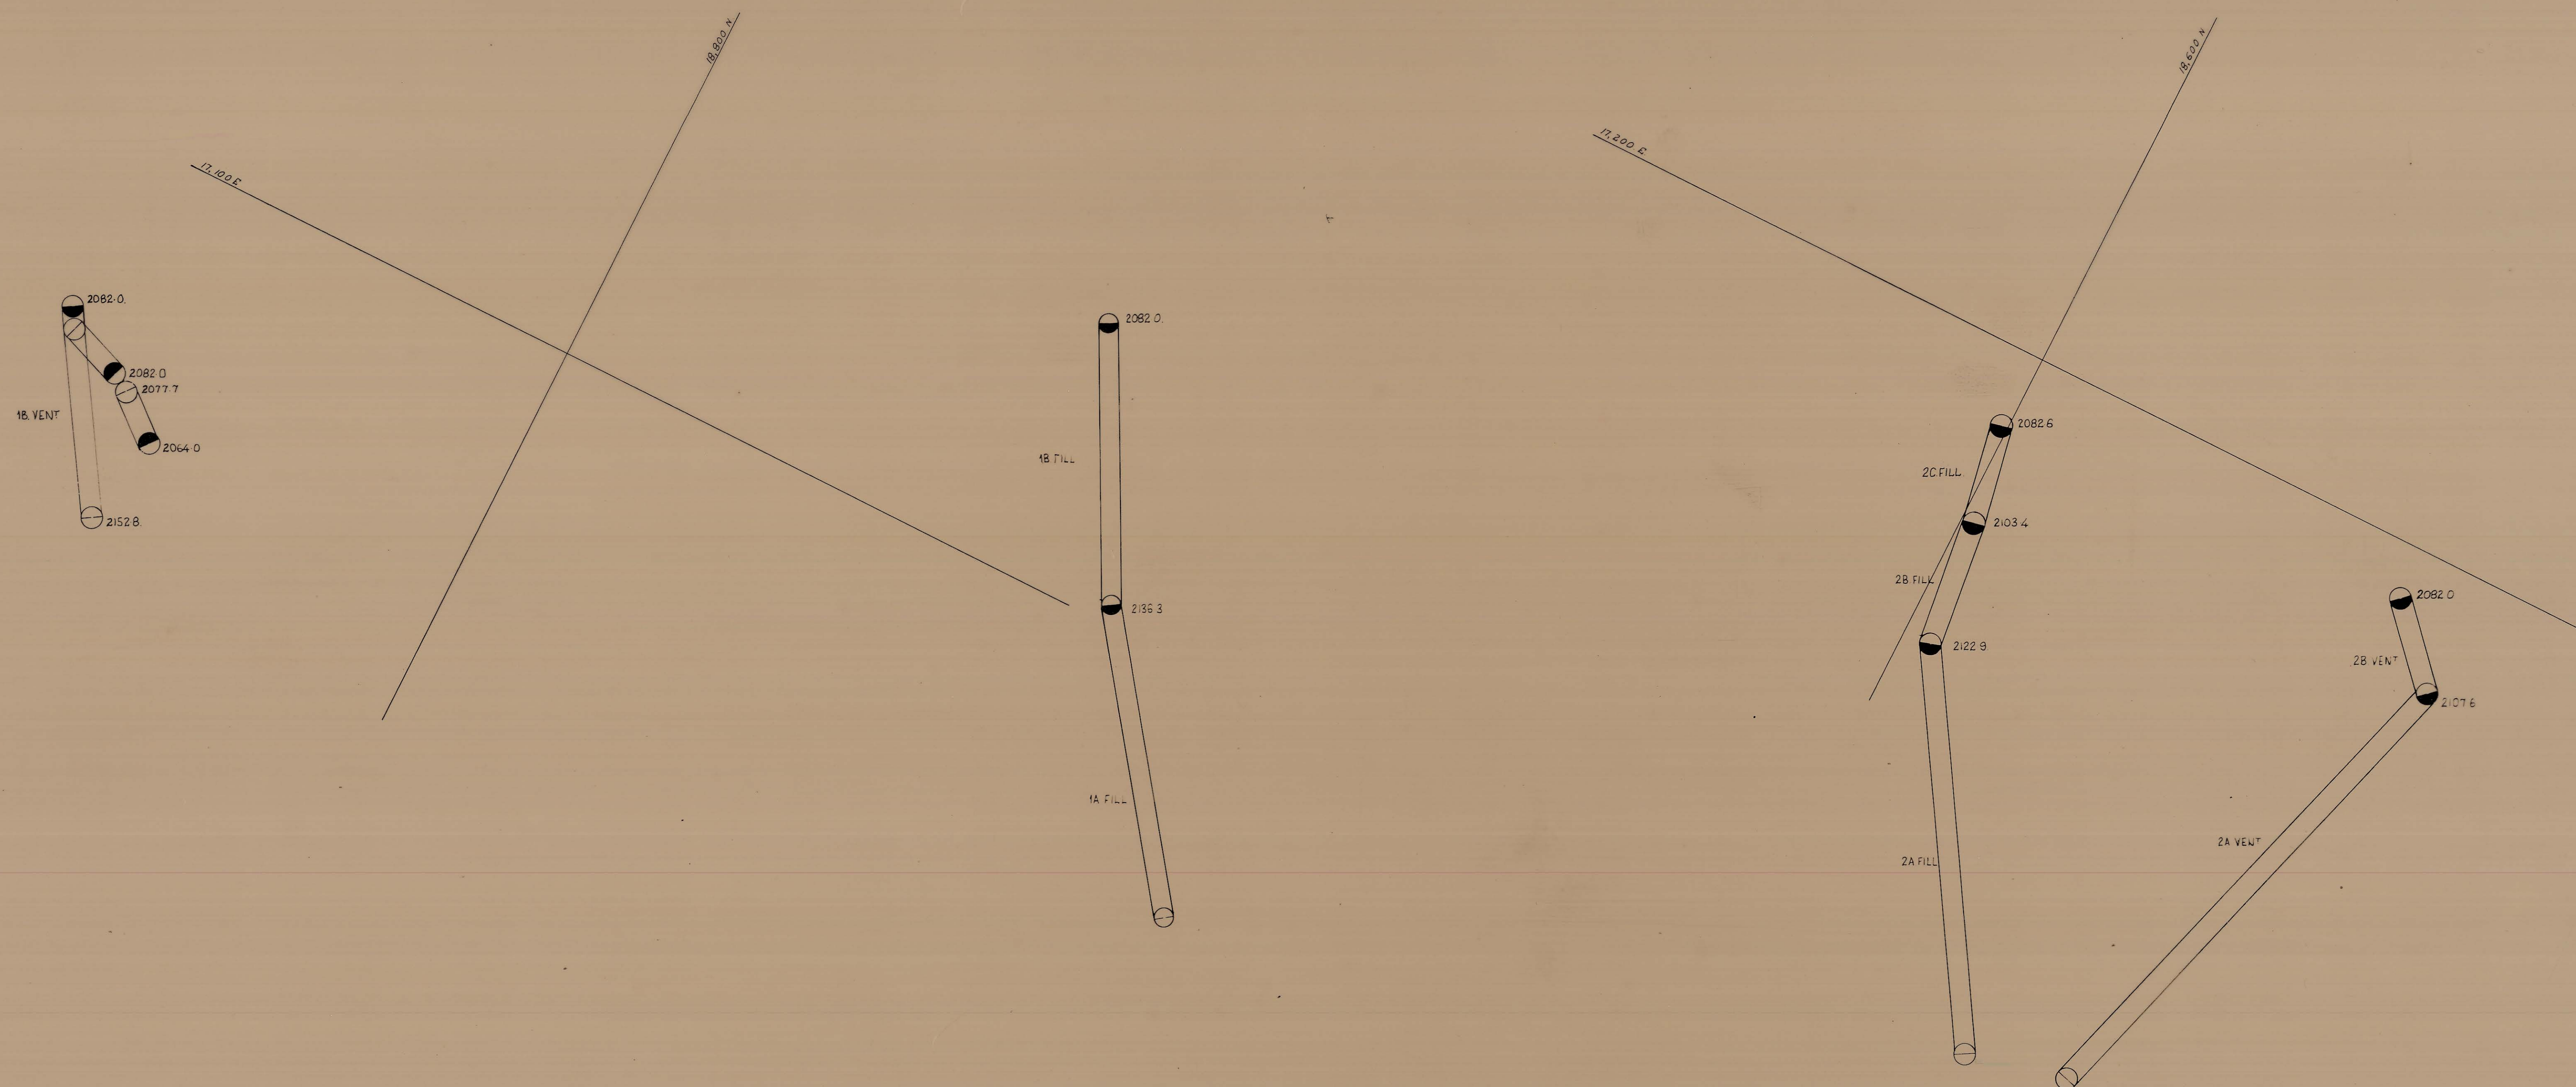

DATE	MANAGER	SURVEYOR	REMISON LIMITED SURVEY		DRAWING NO.
31-12-73	<i>[Signature]</i>	<i>[Signature]</i>	DRAWN: P.W.K.		12-038
31-12-74	<i>[Signature]</i>	<i>[Signature]</i>	DATE: 7 3 75		77040
31-12-75	<i>[Signature]</i>	<i>[Signature]</i>	SCALE: 1:500		
31-12-76	<i>[Signature]</i>	<i>[Signature]</i>	FEDERAL STOPE COMPOSITE RISES		