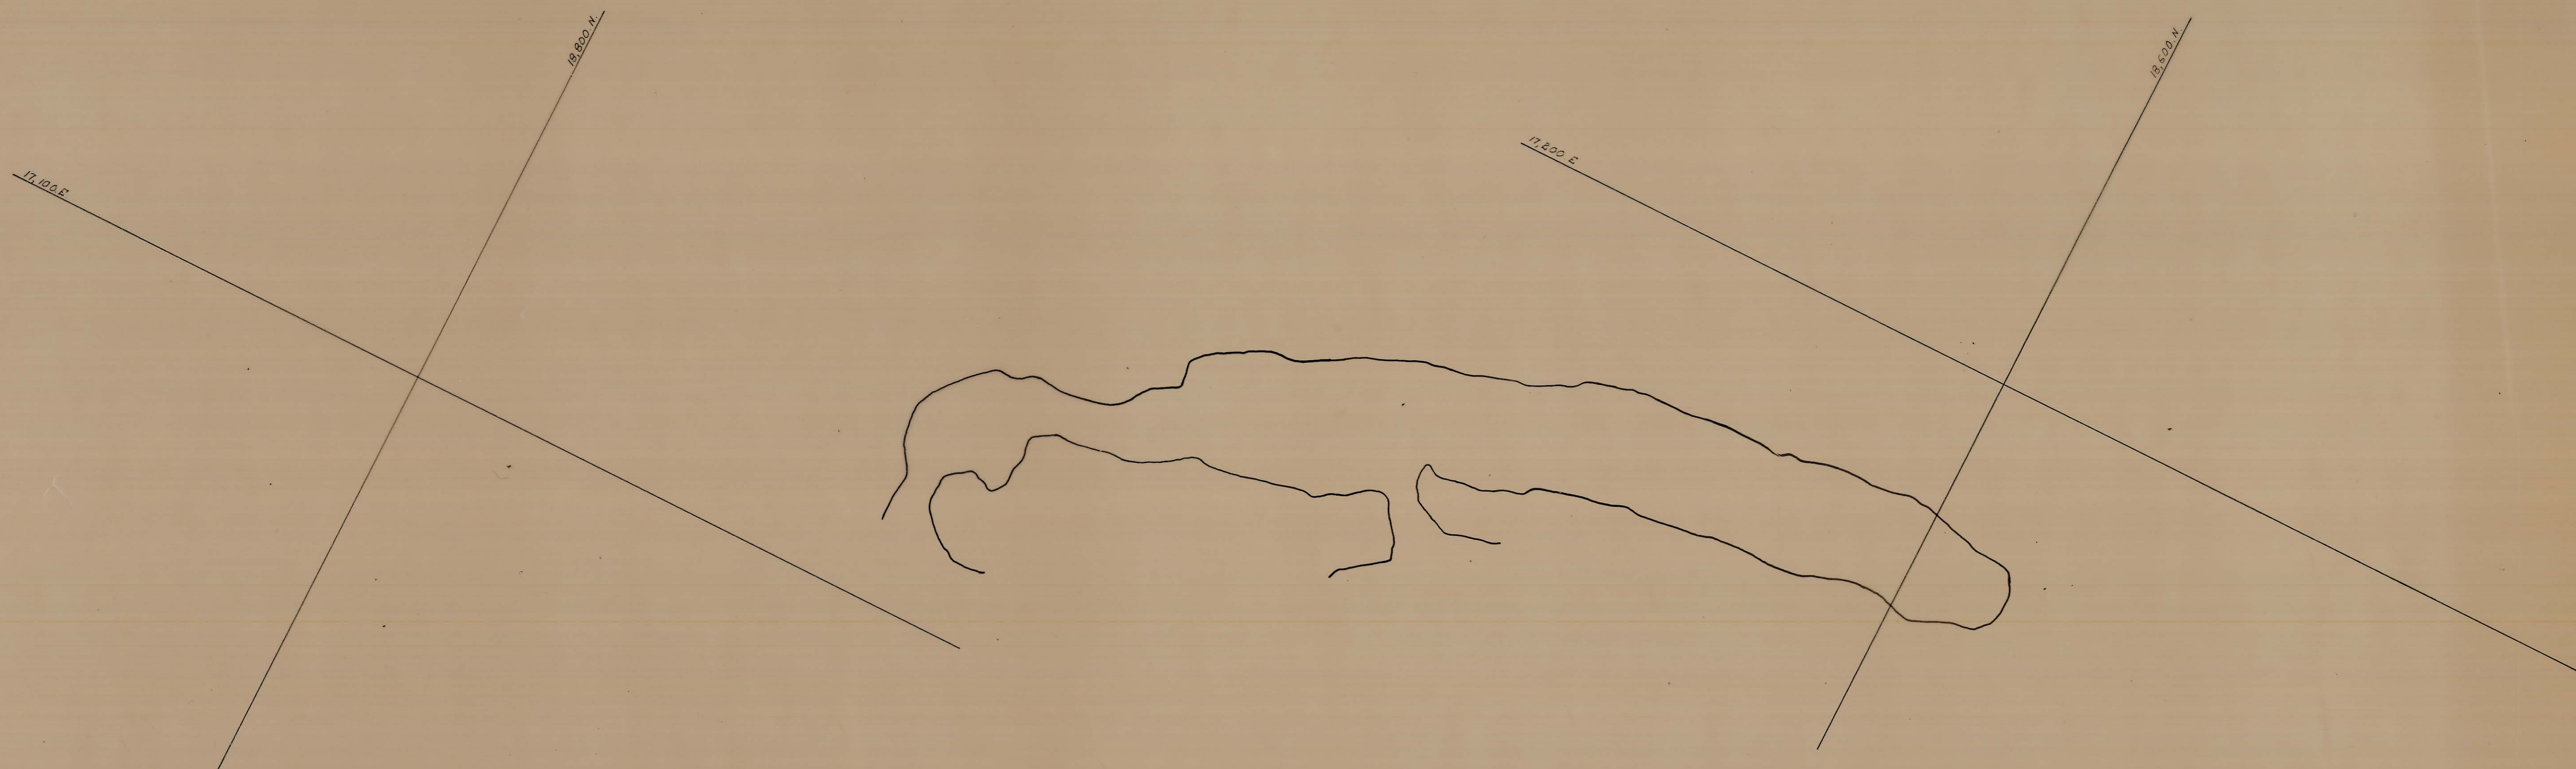


| REINSON LIMITED SURVEY   |                    |                    | DRAWING NO. |  |
|--------------------------|--------------------|--------------------|-------------|--|
| DATE                     | MANAGER            | SURVEYOR           | 12-038      |  |
| 31-12-73                 | <i>[Signature]</i> | <i>[Signature]</i> |             |  |
| 31-12-74                 | <i>[Signature]</i> | <i>[Signature]</i> |             |  |
| 31-12-75                 | <i>[Signature]</i> | <i>[Signature]</i> |             |  |
| FEDERAL STOPE LEVEL 2115 |                    |                    | 77035       |  |