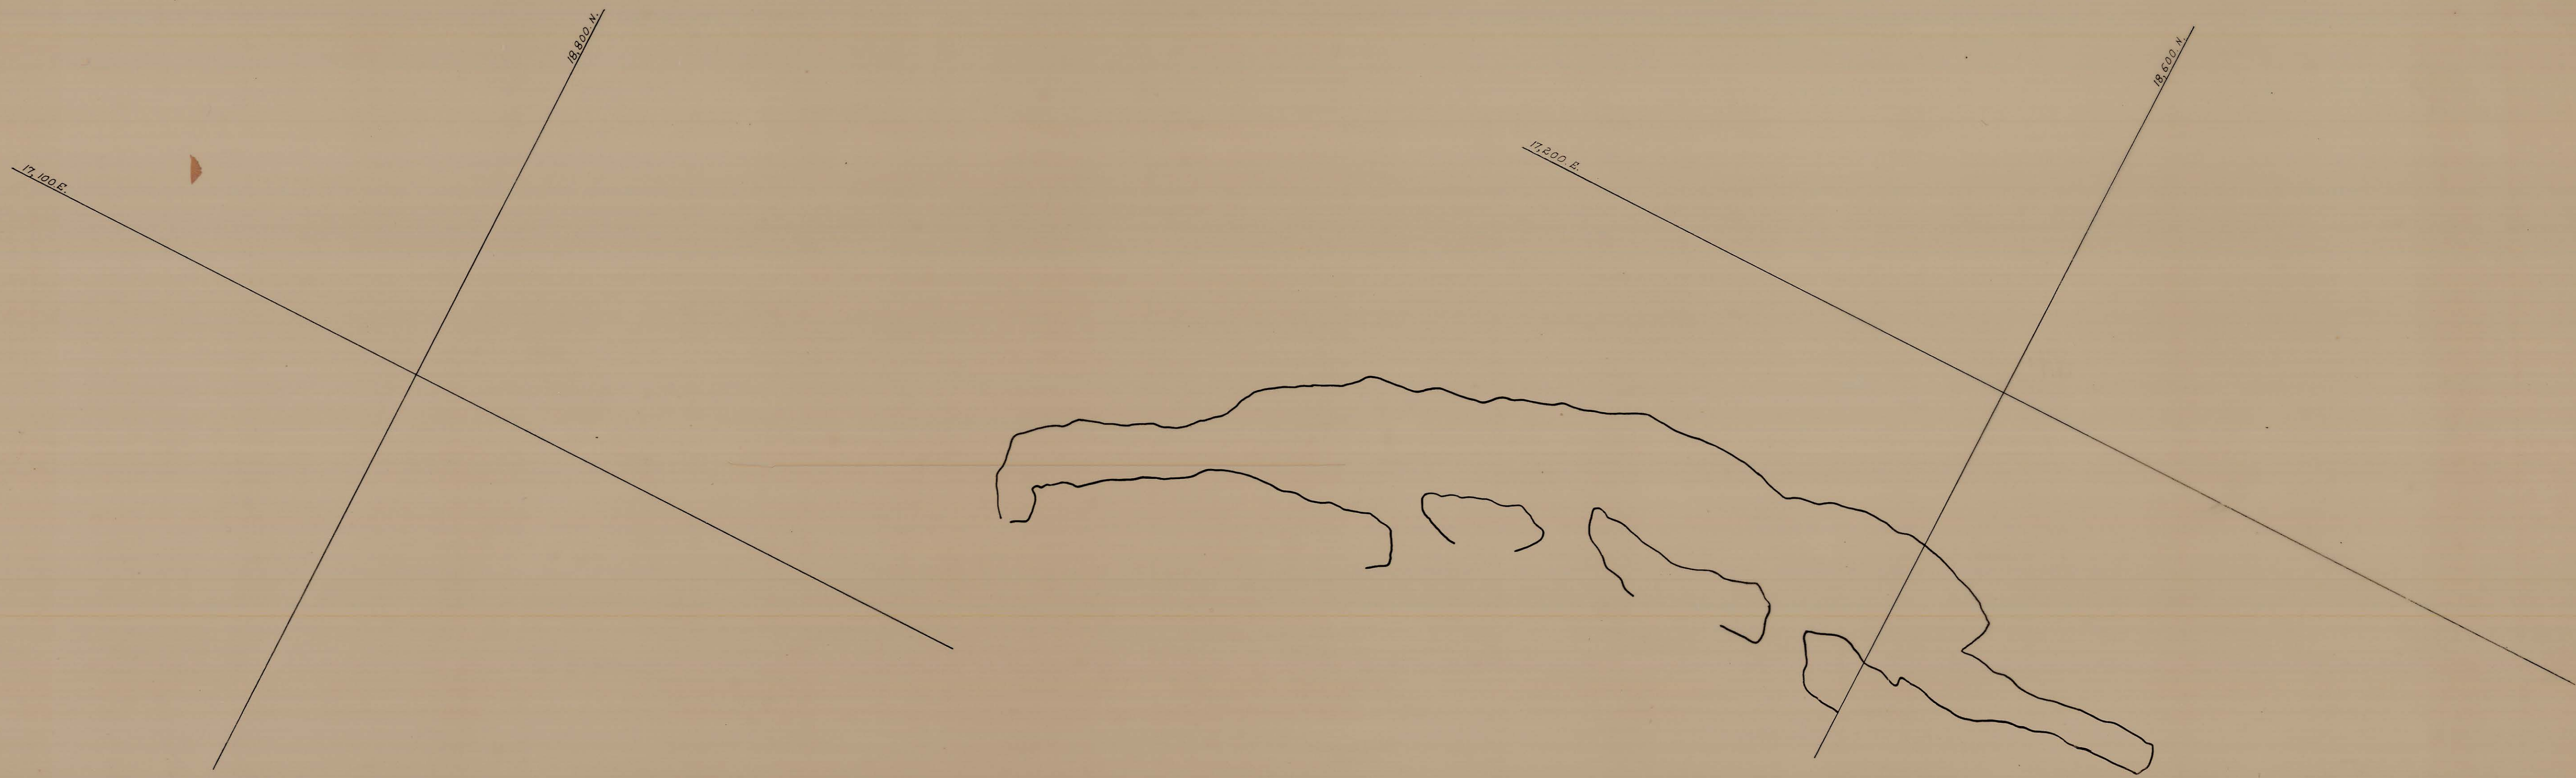


DATE	MANAGER	SURVEYOR	RENISON LIMITED SURVEY			DRAWING NO.
01-12-73	<i>[Signature]</i>	<i>[Signature]</i>	DRAWN: P.W.K. DATE: 7.3.74 SCALE: 1:500			12:038
01-12-74	<i>[Signature]</i>	<i>[Signature]</i>				
01-12-75	<i>[Signature]</i>	<i>[Signature]</i>				
01-12-76	<i>[Signature]</i>	<i>[Signature]</i>				
			FEDERAL STOPE LEVEL 2120			