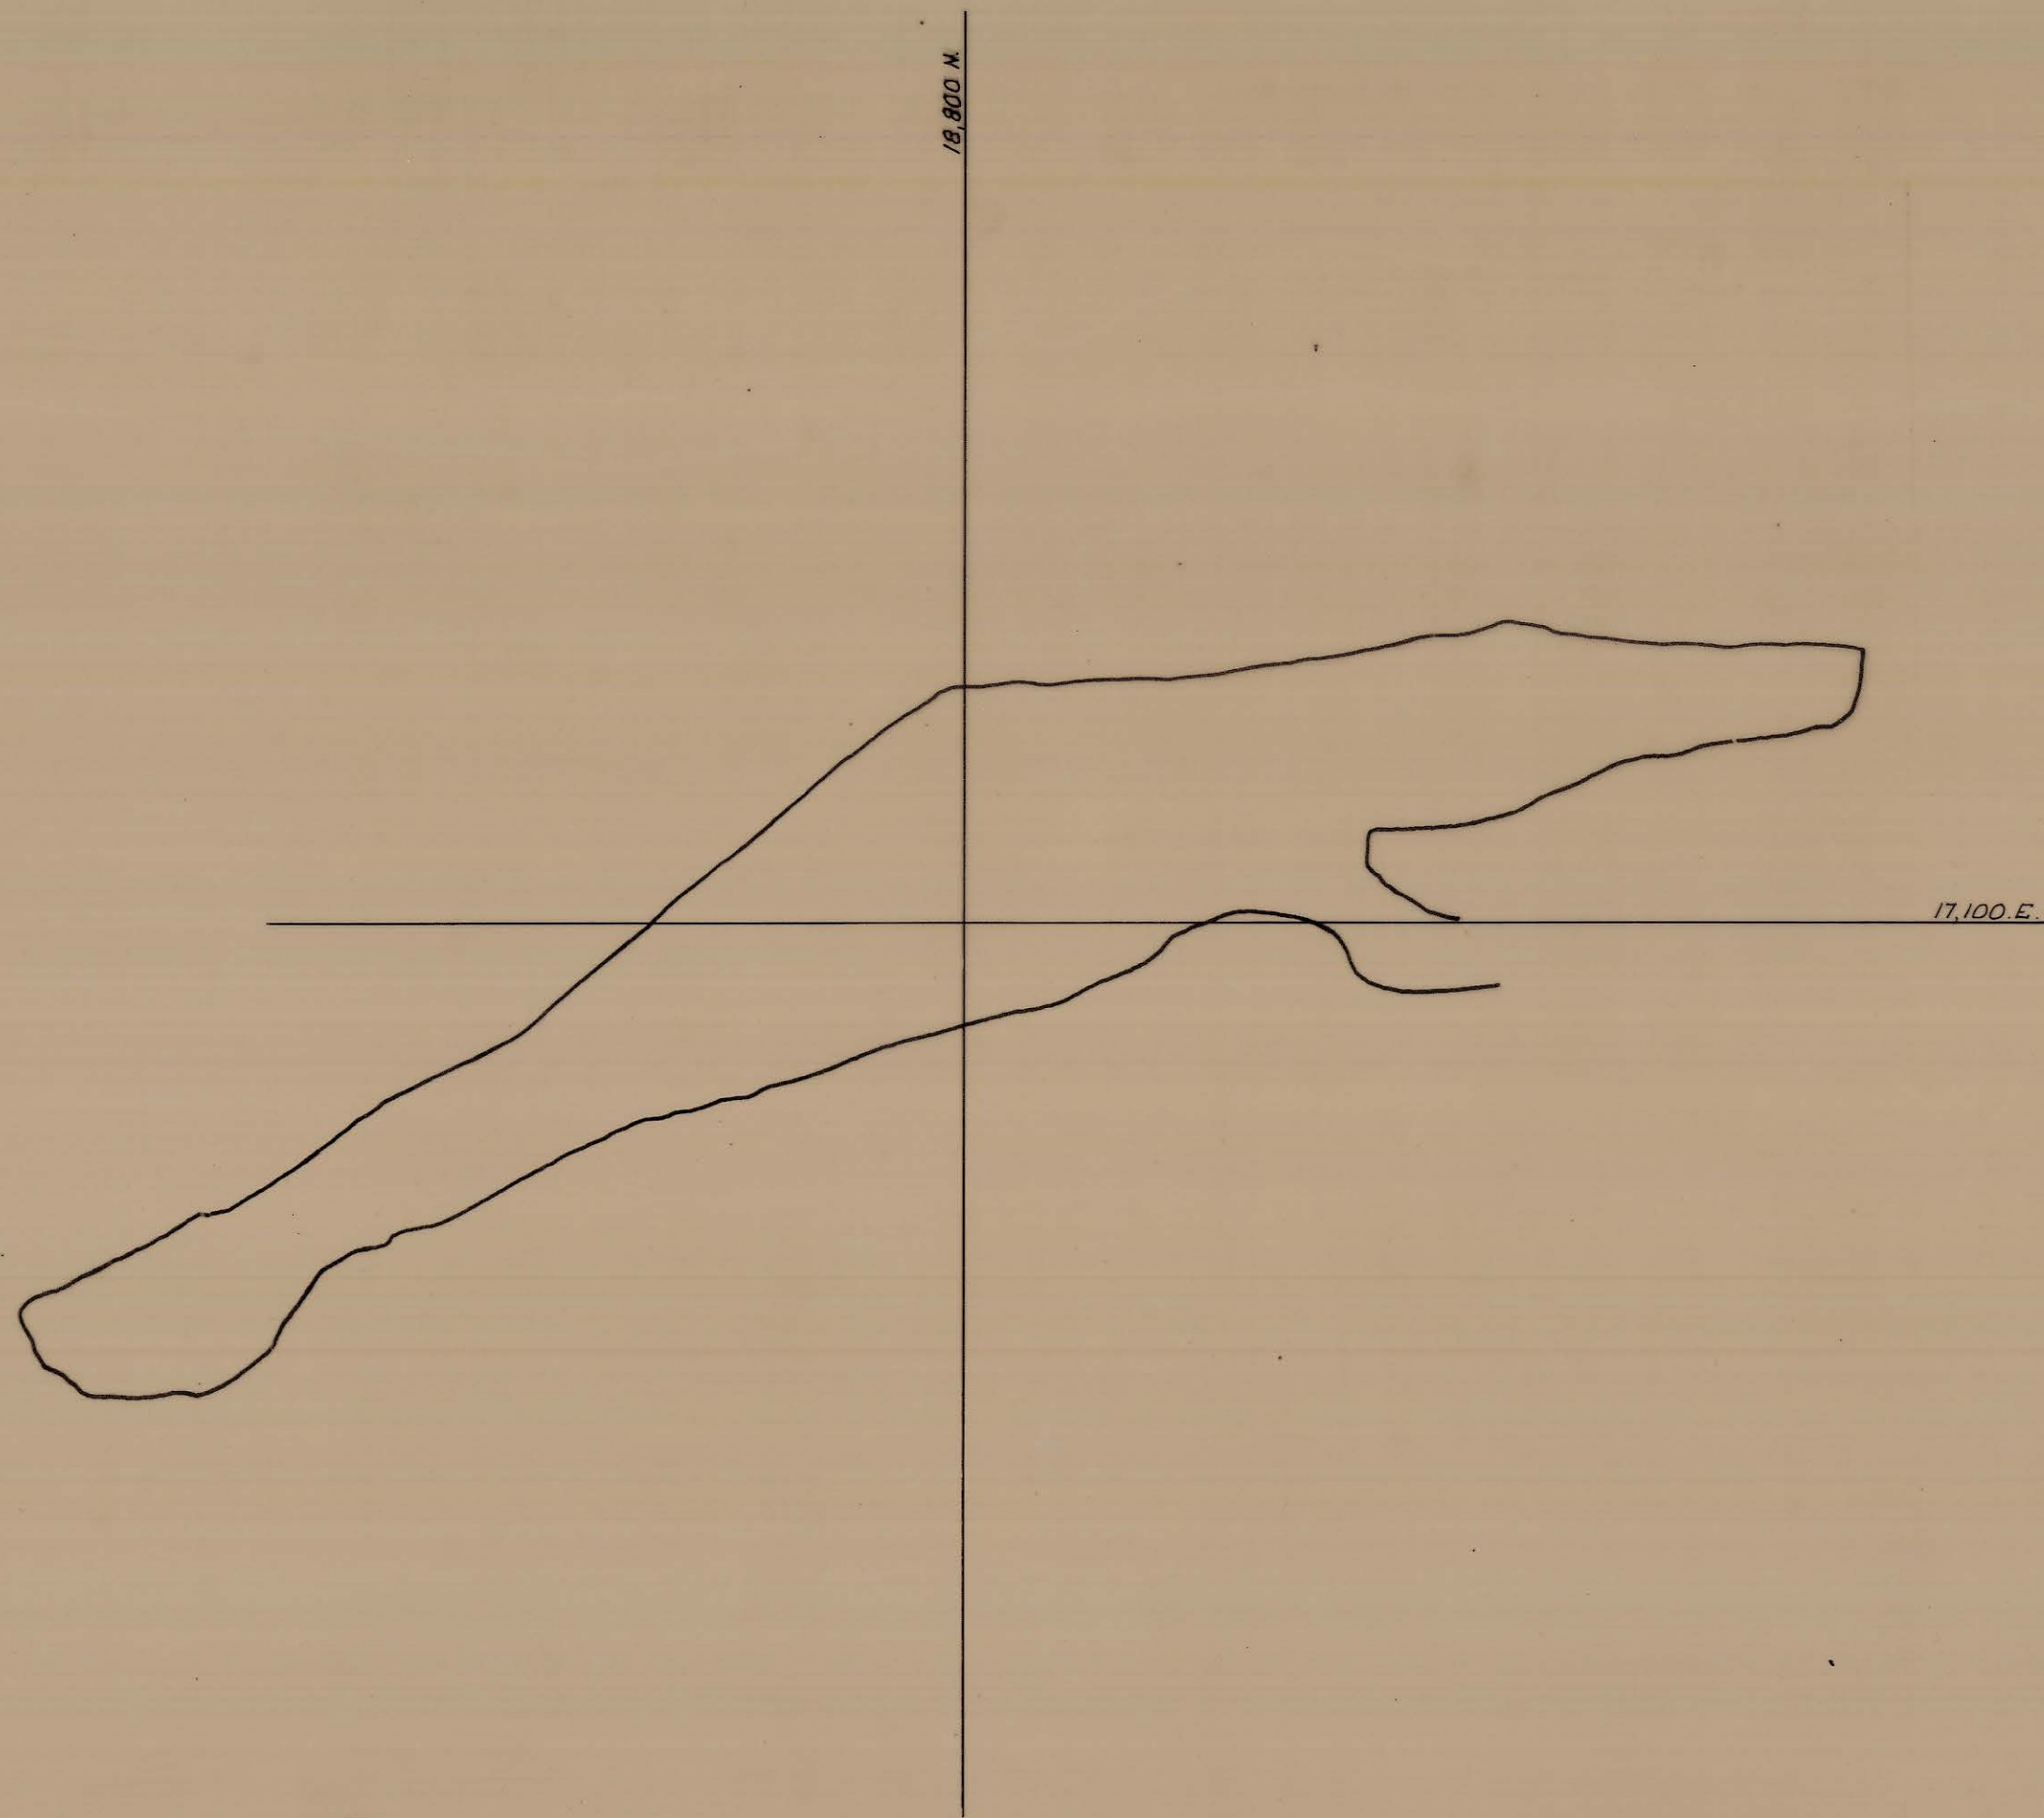


DATE	MANAGER	SURVEYOR	RENISON LIMITED SURVEY			DRAWING N°
31-12-73	<i>[Signature]</i>	<i>[Signature]</i>	DRAWN: P.W.K. DATE: 7.3.73 SCALE: 1:500			12:038
31-12-74	<i>[Signature]</i>	<i>[Signature]</i>				
31-12-75	<i>[Signature]</i>	<i>[Signature]</i>	NORTH FEDERAL SLOPE LEVEL 2104			77033
31-12-76	<i>[Signature]</i>	<i>[Signature]</i>				