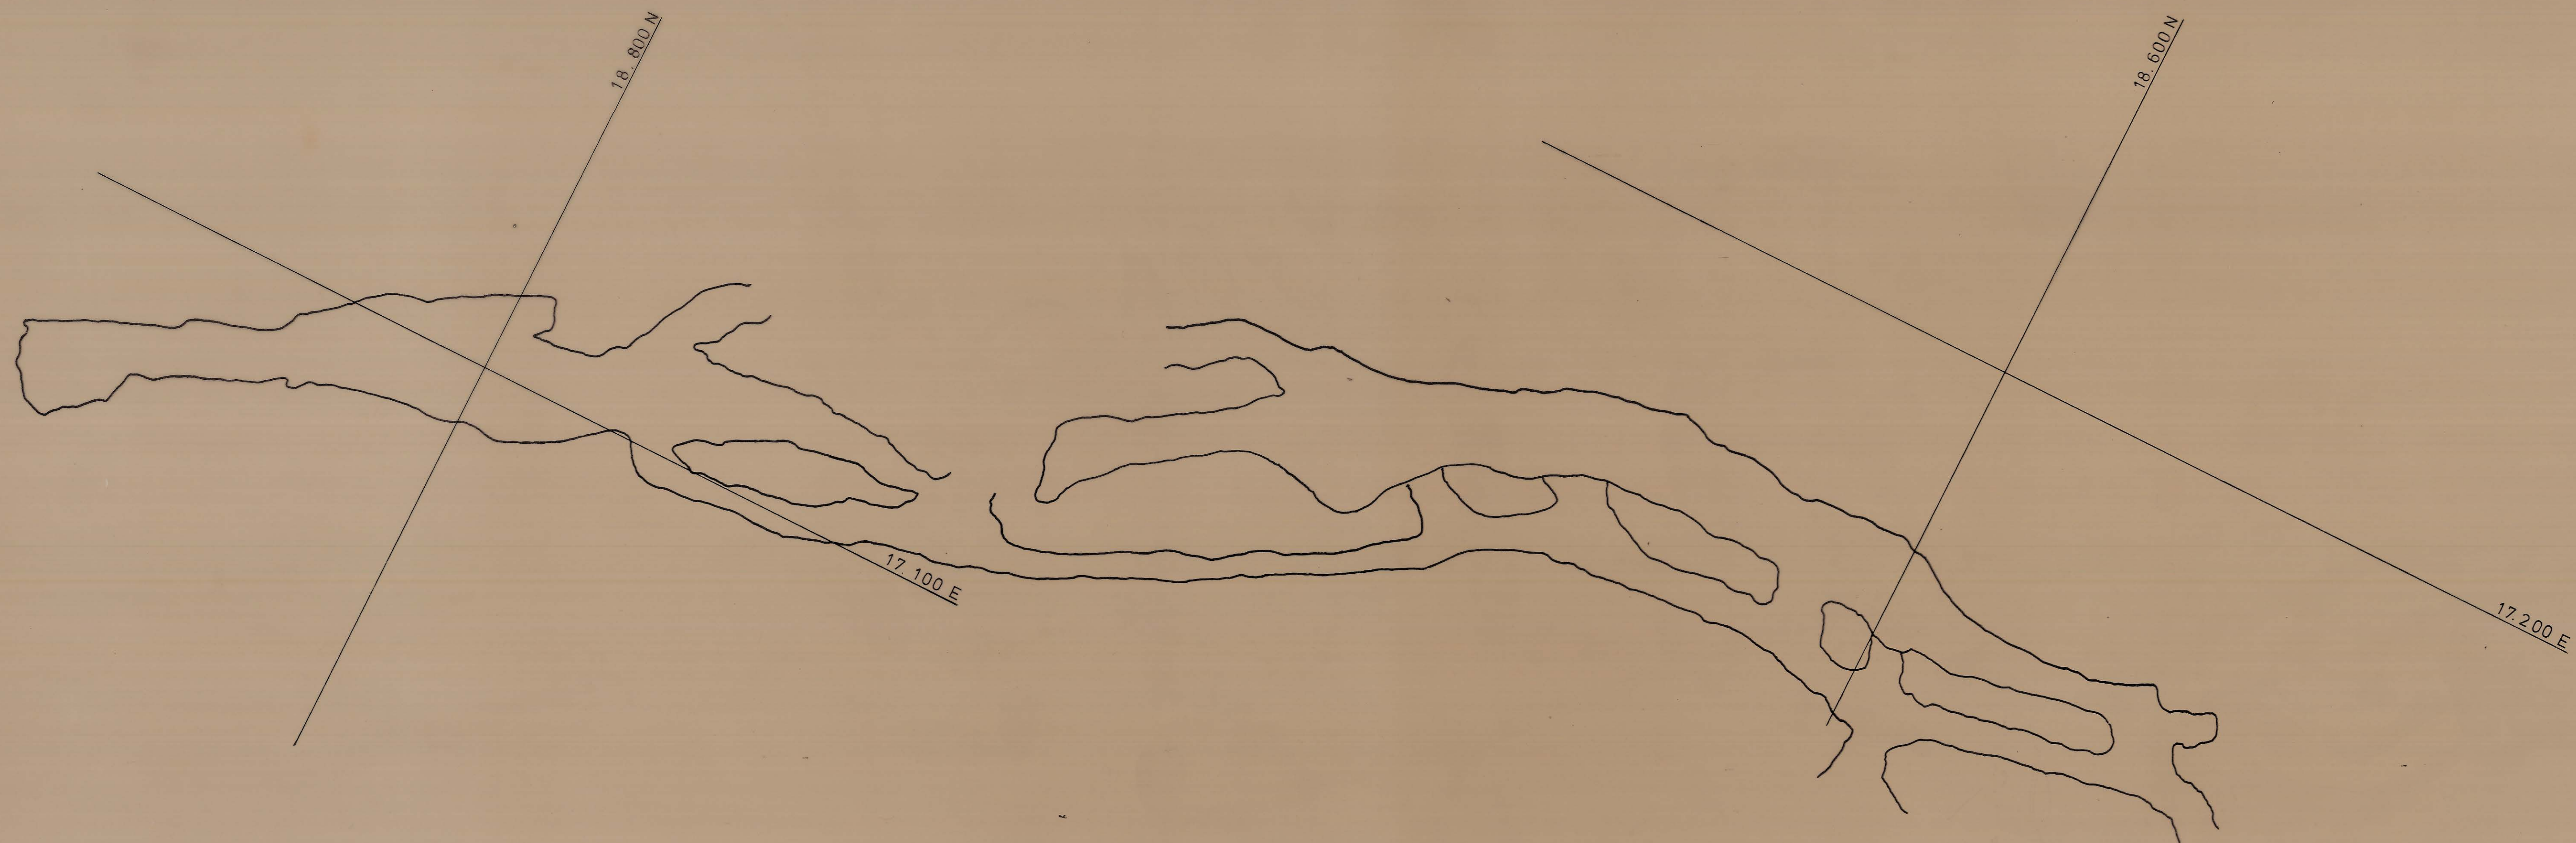


DATE		MANAGER		SURVEYOR		RENISON LIMITED				DRAWING N°
3/12/74		[Signature]		[Signature]		SURVEY				
3/12/74		[Signature]		[Signature]		DRAWN: A.J.M.		DATE: 13-11-74		SCALE: 1:500
3/12/74		[Signature]		[Signature]		NORTH FEDERAL STOPE. LEVEL: 2105.				
						SOUTH FEDERAL STOPE. LEVEL: 2125.				