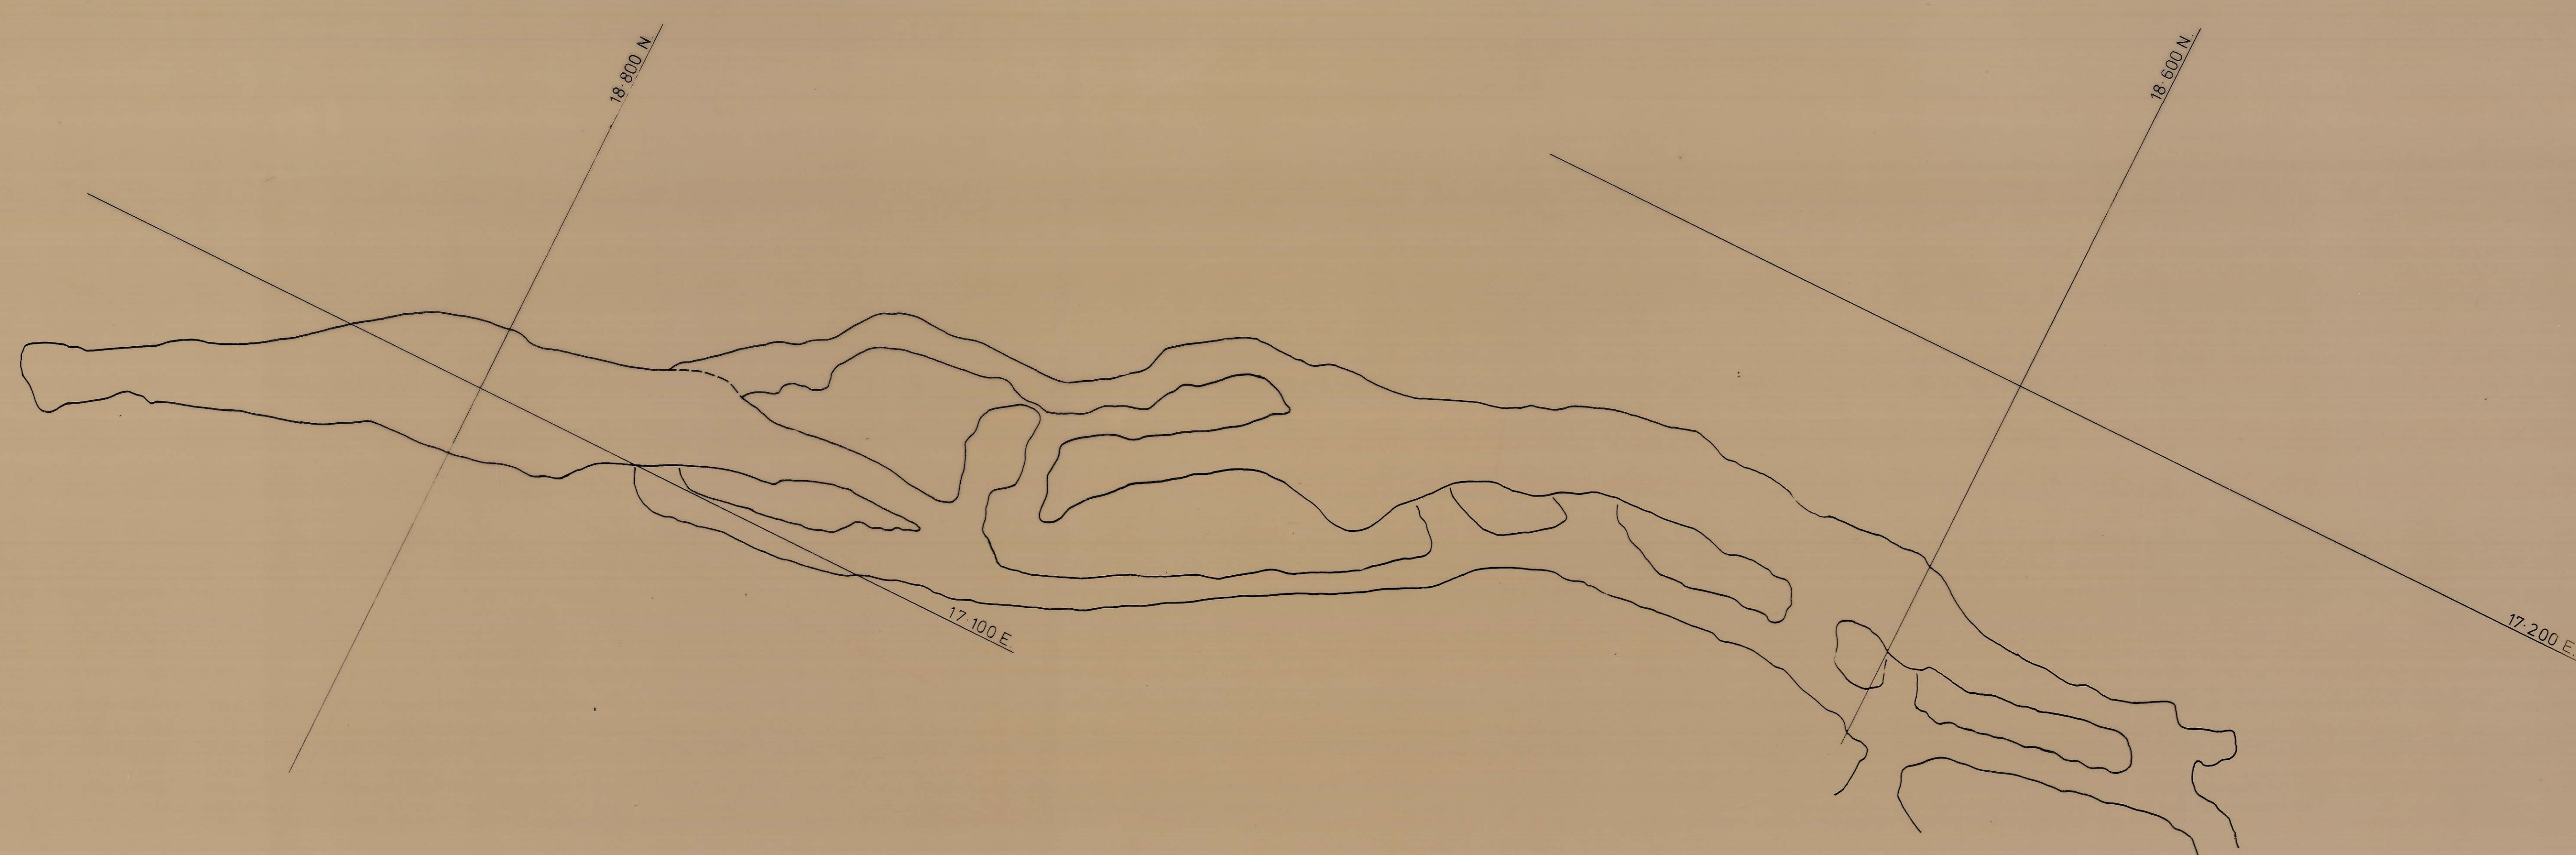


DATE	MAPPER	SURVEYOR	REMISON LIMITED		DRAWING NO.
31-12-75	V. J. [signature]	[signature]	SURVEY		12-038
31-12-75	[signature]	[signature]	DRAWN: F.M.H.	DATE: 9-12-75	SCALE: 1:500
			NORTH FEDERAL STOPE. LEVEL: 2108.		
			SOUTH FEDERAL STOPE. LEVEL: 2125.		