
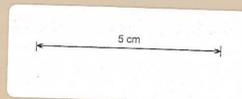


16-700 E.

19-000 N

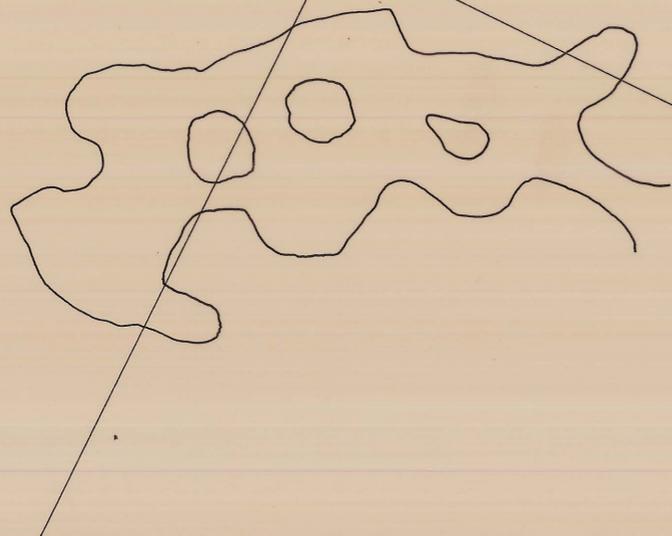

DATE	MANAGER	SURVEYOR	RENISON LIMITED SURVEY.		DRAWING No.
31-12-76	<i>[Signature]</i>	<i>[Signature]</i>	DRAWN F.M.H.	DATE 21-2-77	SCALE 1:500
			UPPER BREAKNOUGHT STOPE.		17:001.
			LEVEL: 2173.		77088

0376_618