


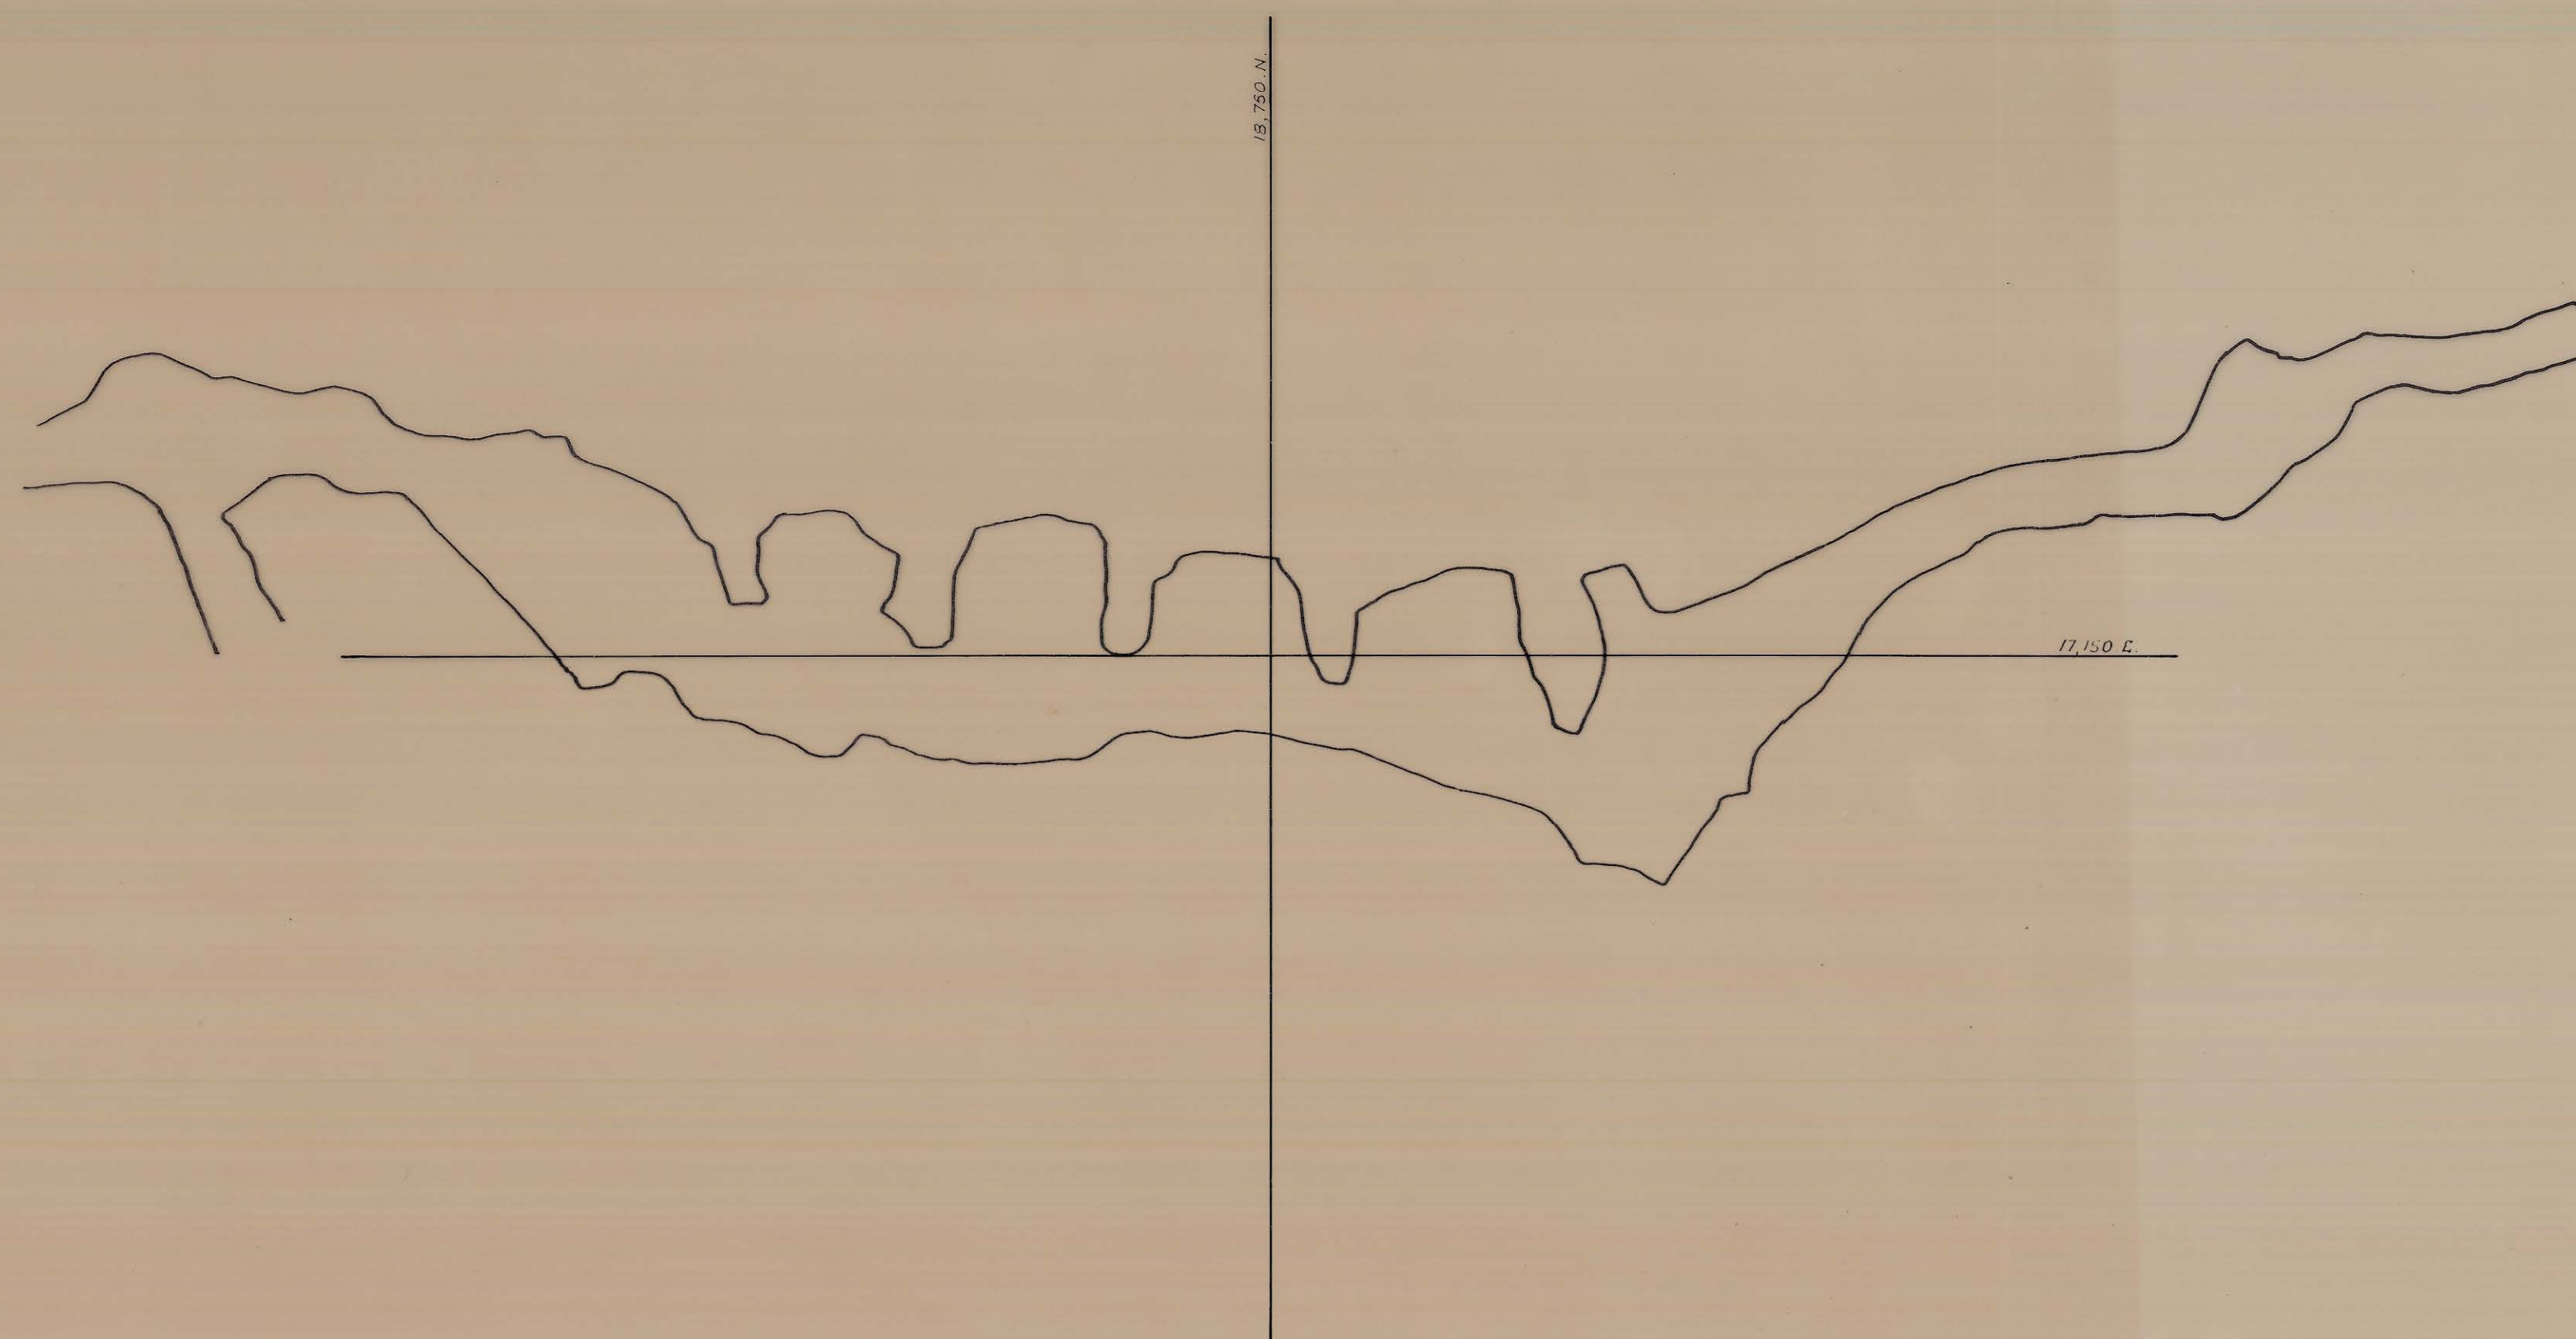

DATE	MANAGER	SURVEYOR	RENISON LIMITED SURVEY DRAWN: PWK DATE: 7-3-74 SCALE: 1:500 1900 NORTH STEBBINS. LEVEL: 1900.0	DRAWING NO
31-12-74	<i>[Signature]</i>	<i>[Signature]</i>		73-001. 77096
31-12-75	<i>[Signature]</i>	<i>[Signature]</i>		
31-12-76	<i>[Signature]</i>	<i>[Signature]</i>		