


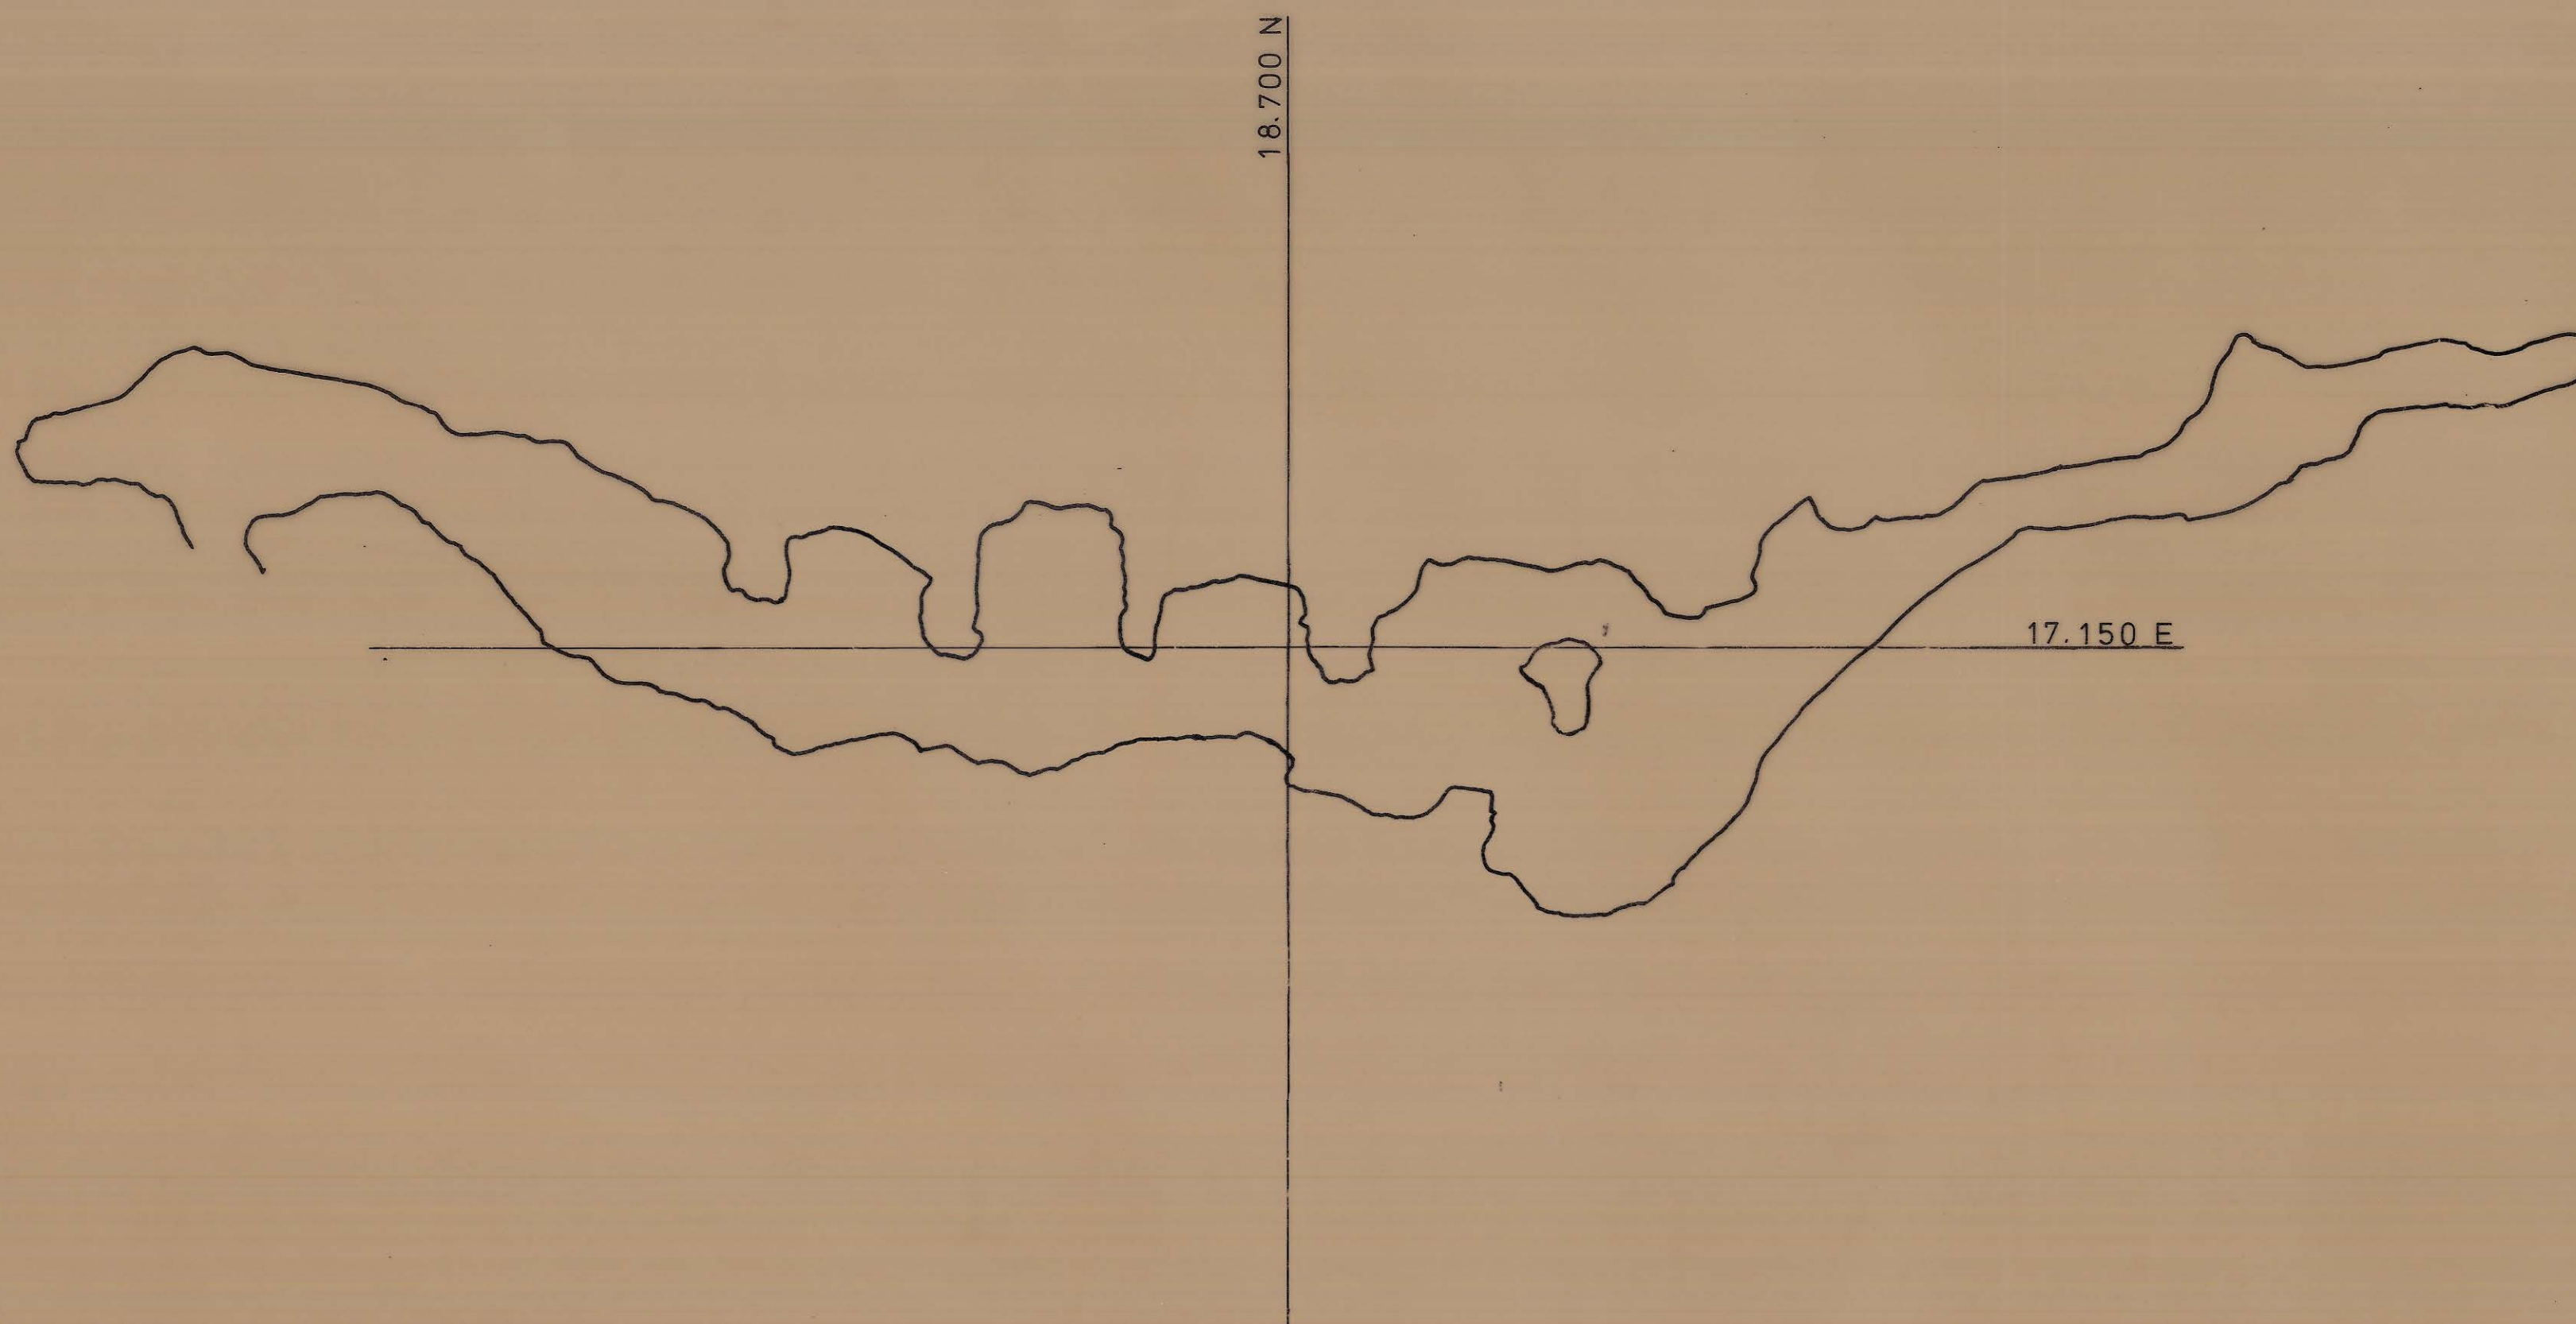

5 cm

DATE.	MANAGER.	SURVEYOR.	RENISON LIMITED. SURVEY.			DRAWING No.
31-12-74	<i>[Signature]</i>	<i>[Signature]</i>	DRAWN: A. J. M.	DATE: 9. 12. 74.	SCALE: 1:500	73:001. 77085
31-12-75	<i>[Signature]</i>	<i>[Signature]</i>				
31-12-76	<i>[Signature]</i>	<i>[Signature]</i>				
			1900 NORTH STEBBINS LEVEL: 1904			