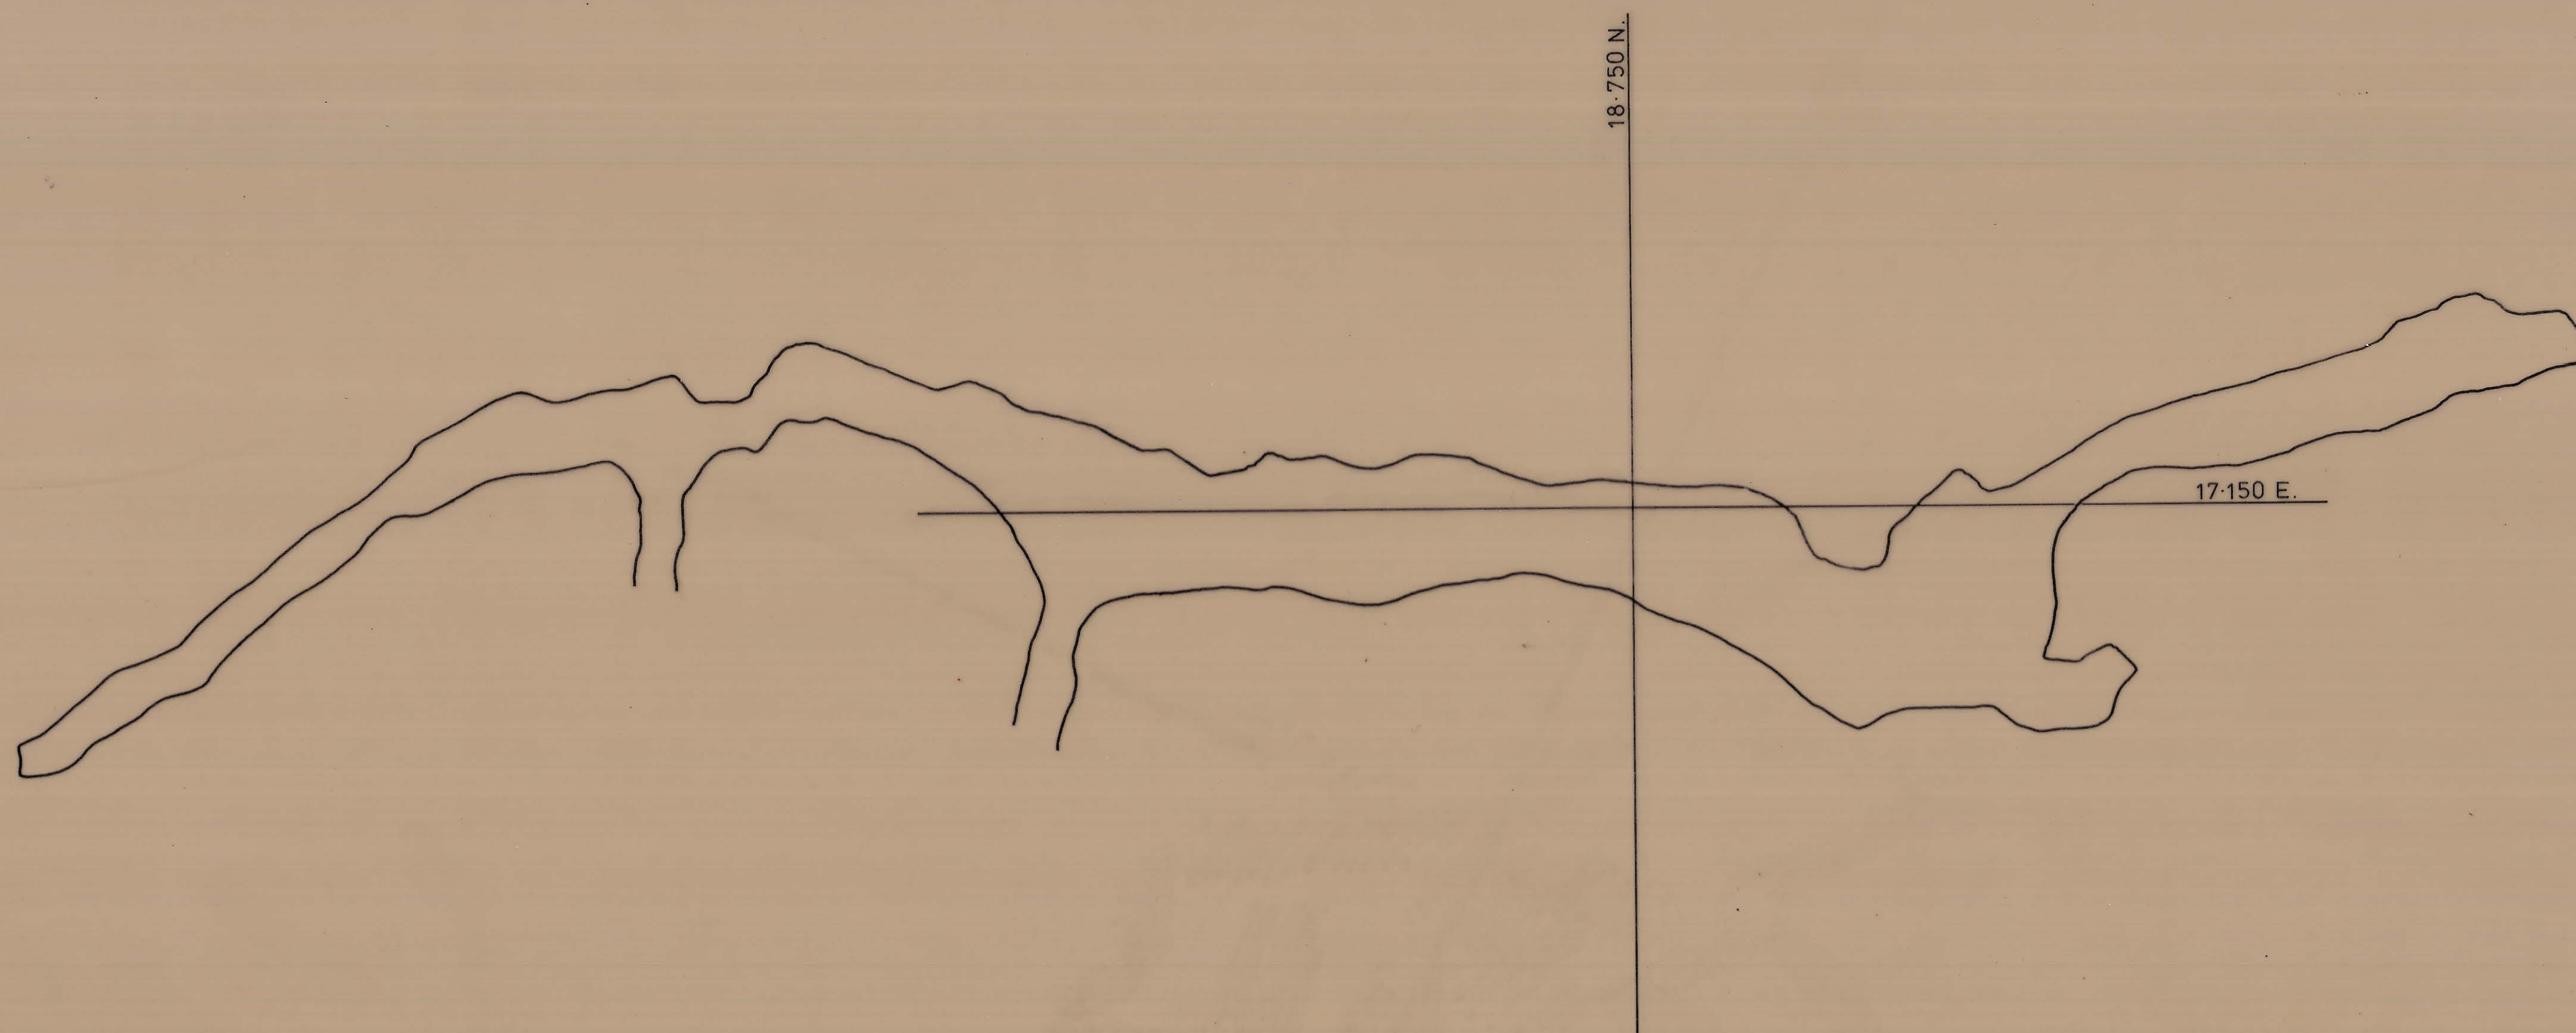


DATE	MANAGER	SURVEYOR	RENISON LIMITED SURVEY.			DRAWING No.
31-12-75	V.K. [Signature]	[Signature]	DRAWN: F.M.H. DATE: 10-12-75 SCALE: 1:500			73-001
31-12-76	[Signature]	[Signature]	1900 NORTH STEBBINS LEVEL : 1912.			77083

0376_623