


LIFT N^o 1

REINSON LIMITED		DRAWN	F.M.H.	APPROVED
SURVEY		TRACED		CHIEF SURVEYOR
SURVEY	DATE 13-12-79	SCALE 1:500	CHECKED	
1910 PENZANCE (Nth.)			DRAWING No.	
FILL LEVEL: SILL			91:001/B	
			LIFT LEVEL: 1912.7	

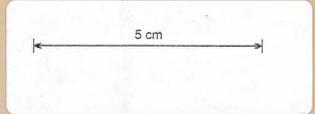

0326-635

80057